


T. 5 & 6 S., R. 4 W., W. M.

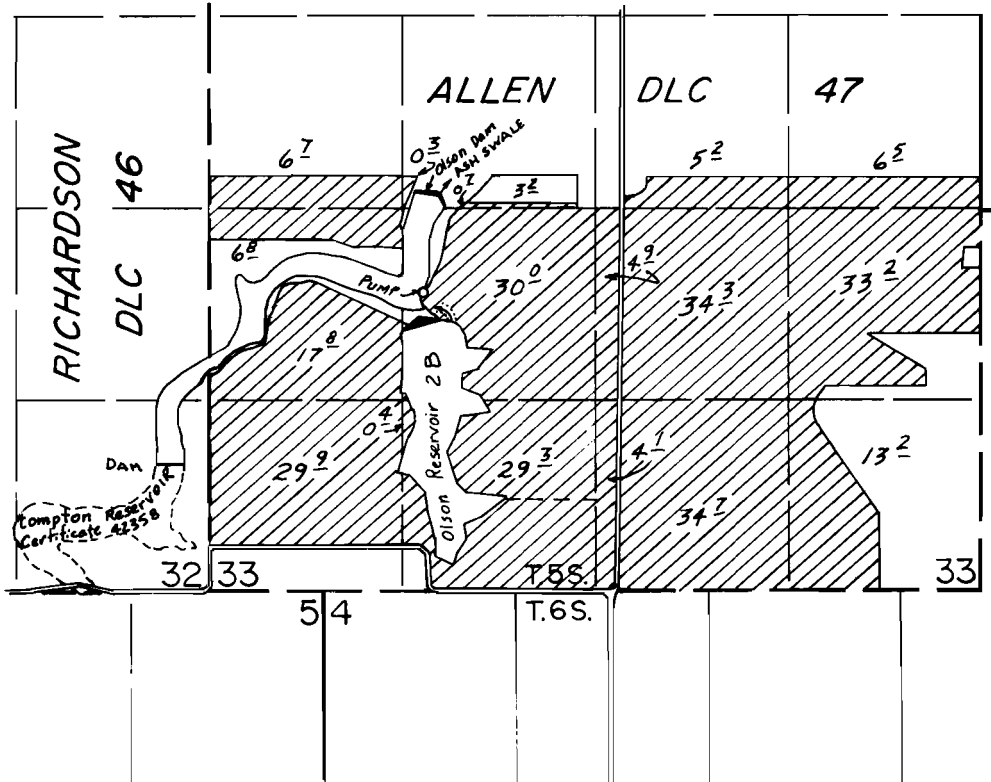

Div. Pts. Loc.: 2720' N. & 1570' E.; 1860' N. & 1450' E., BOTH FROM SW COR. SEC. 33.

FINAL PROOF SURVEY

UNDER

R-52205

R-6154

52206

38064

R-56697

R-6642

Application No. 56698 Permit No. 41972

IN NAME OF

PHILIP R. OLSON

Surveyed JUNE 5, 1980, by S.C. BROWN