


T. 5&6S., R. 4W., W.M.

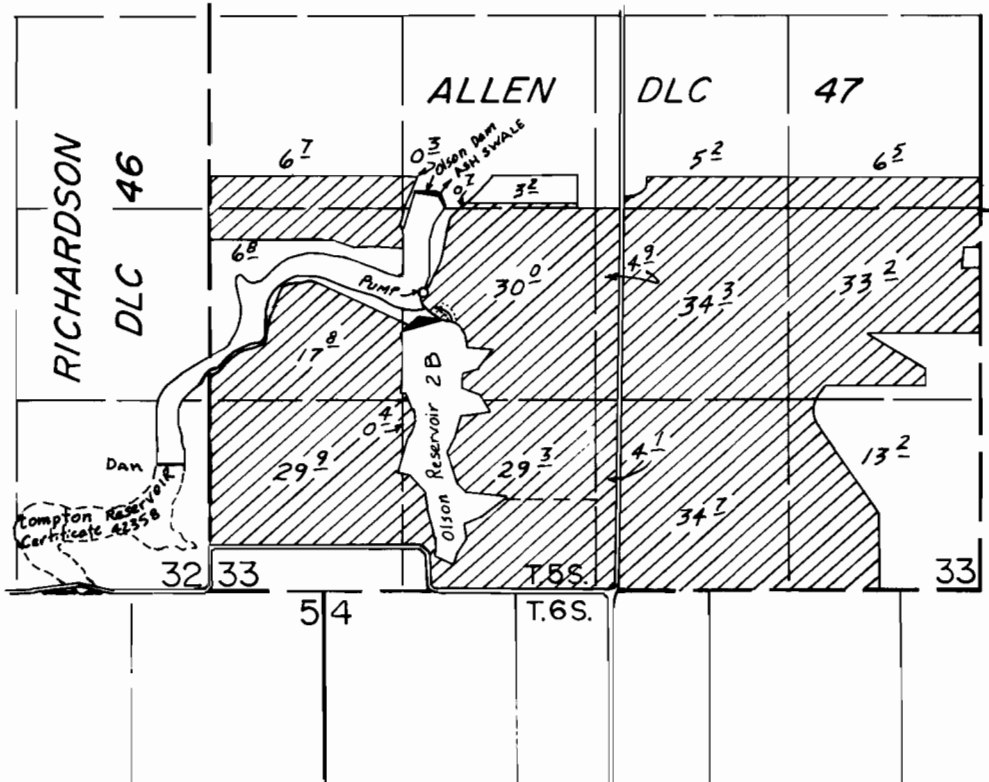

Div. Pts. Loc.: 2720 N. & 1570 E.; 1860 N. & 1450 E., BOTH FROM SW COR. SEC. 33.

FINAL PROOF SURVEY

UNDER

R-52205

52206

R-56697

Application No. 56698.. Permit No. 41972.....

IN NAME OF

..... PHILIP R. OLSON

Surveyed JUNE 5... 1980, by S.C. BROWN.....

DFQ-111-118

PTS-1980-A

Bub