T. 37S., R. 2 W., W.M.

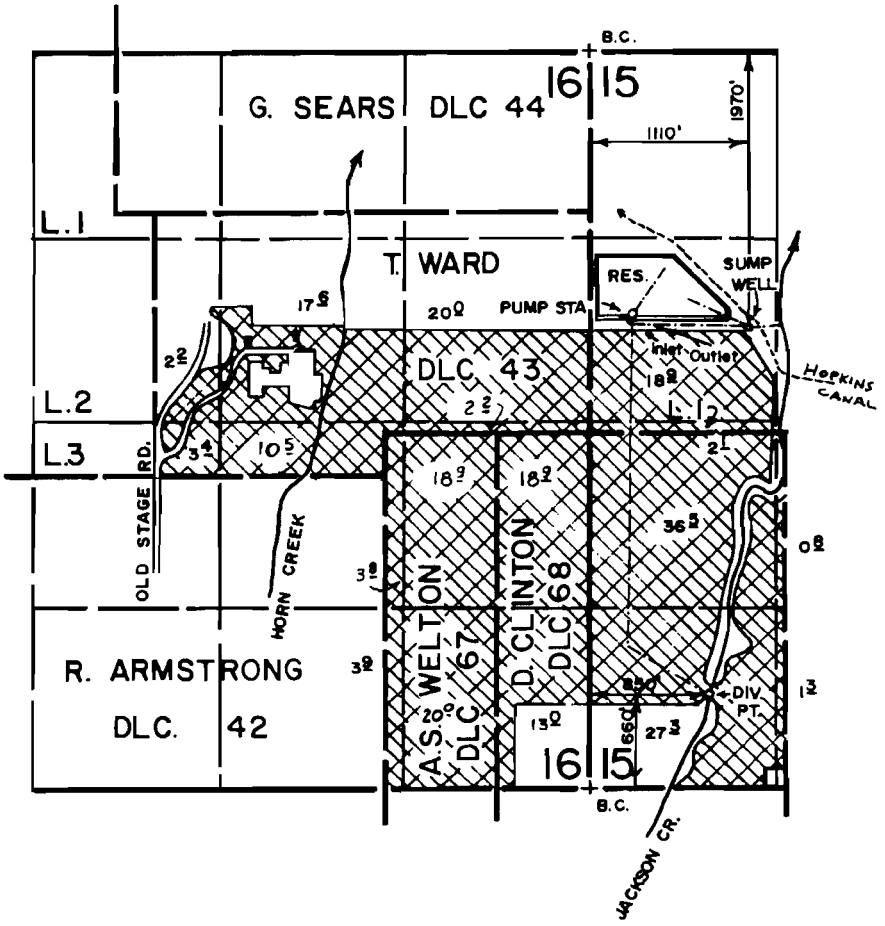

FINAL PROOF SURVEY

UNDER

R-56078	R-6727
56079	42461
56080	42460

Application No. G-9143 Permit No. G-8624

IN NAME OF

ROGUE RIVER NATIONAL FOREST

Surveyed Oct. 21, 1982, by B.S. JAMES

Scale 4" = 1 mile

279-277R