


T. 37 S., R. 2 W., W.M.

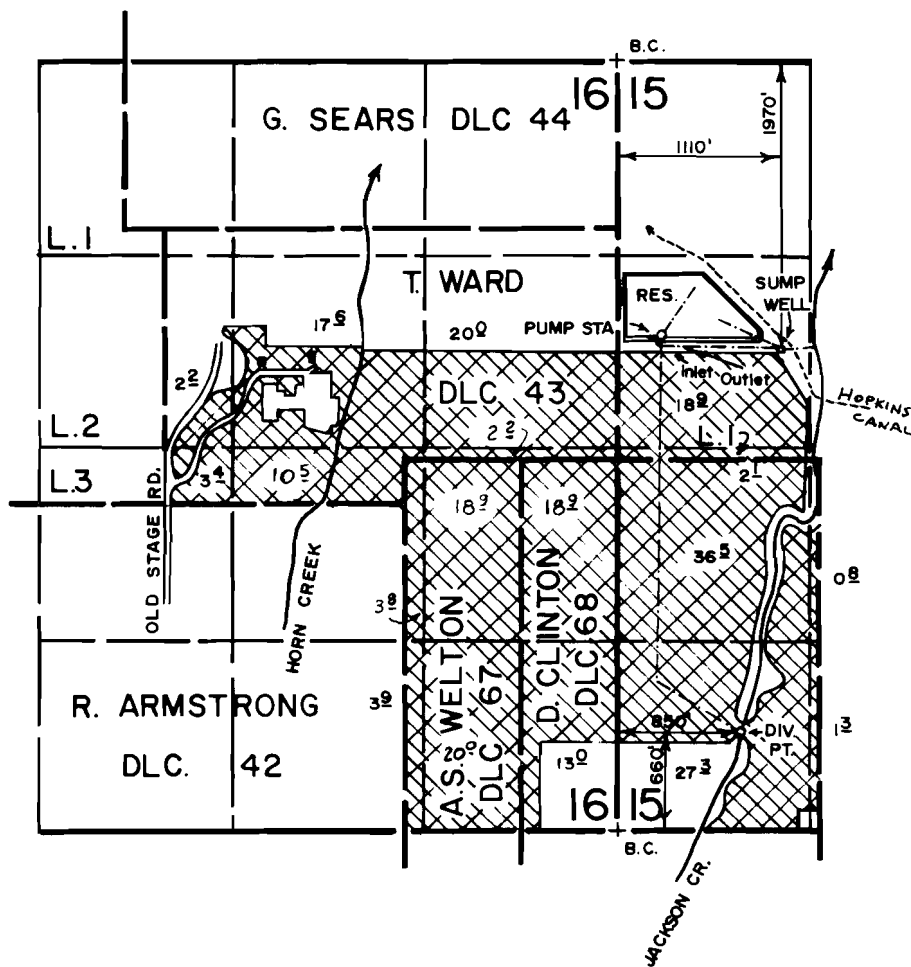

FINAL PROOF SURVEY

UNDER

R-56078

R-6727

56079

42461

56080

42460

Application No. G-9143.. Permit No. G-8624.....

IN NAME OF

ROGUE RIVER NATIONAL FOREST

Surveyed Oct. 21, 1982, by B.S. JAMES.....

Scale 4" = 1 mile