


T.30S. R.2W. W.M.

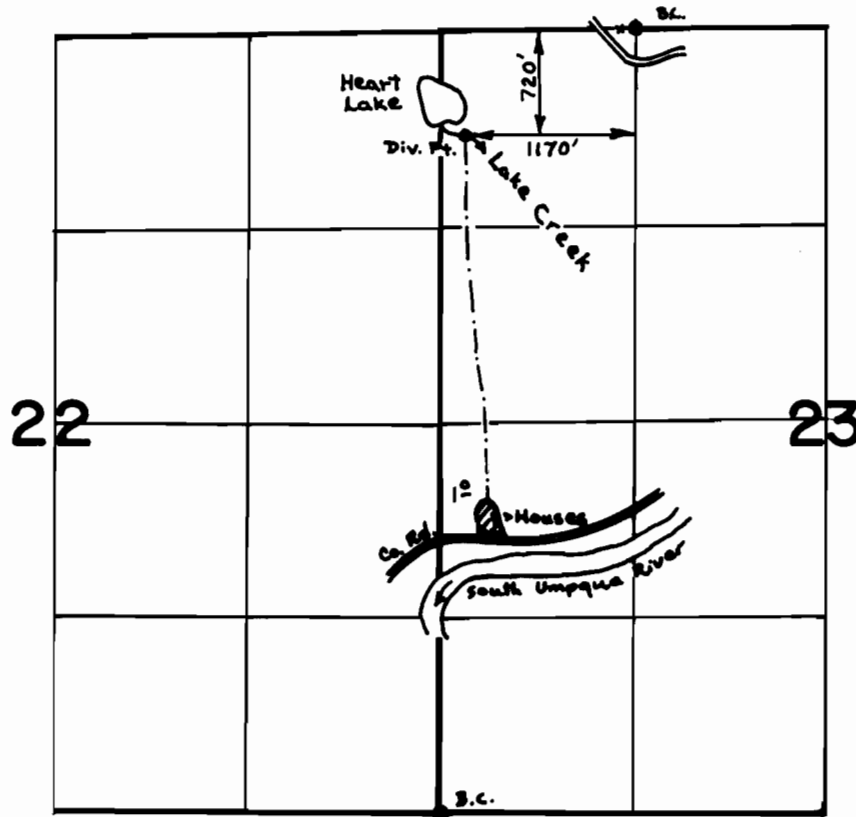

SCALE: 4" = 1 mile

FINAL PROOF SURVEY
UNDER

Application No. 49056... Permit No. 36804
IN NAME OF

LEONARD P. PETERSON

Surveyed Aug. 28, 1978, by D. Sparks.....
March 21, 1979, by S. Donaldson.....