


T.26S., R. 7W., W.M.
SEC. 24

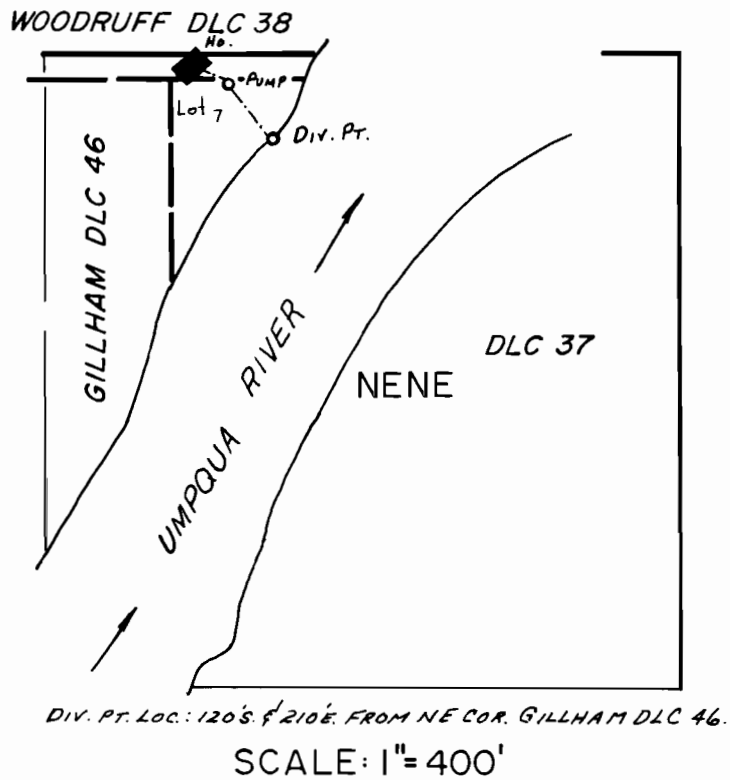

FINAL PROOF SURVEY
UNDER

Application No. 59725... Permit No. 44706...
IN NAME OF

.....ROBERT GORDON ILER.....

Surveyed APR. 2... 1980, by J.S. DONALDSON