


T.26S.,R.3W.,W.M.  
SEC. 34

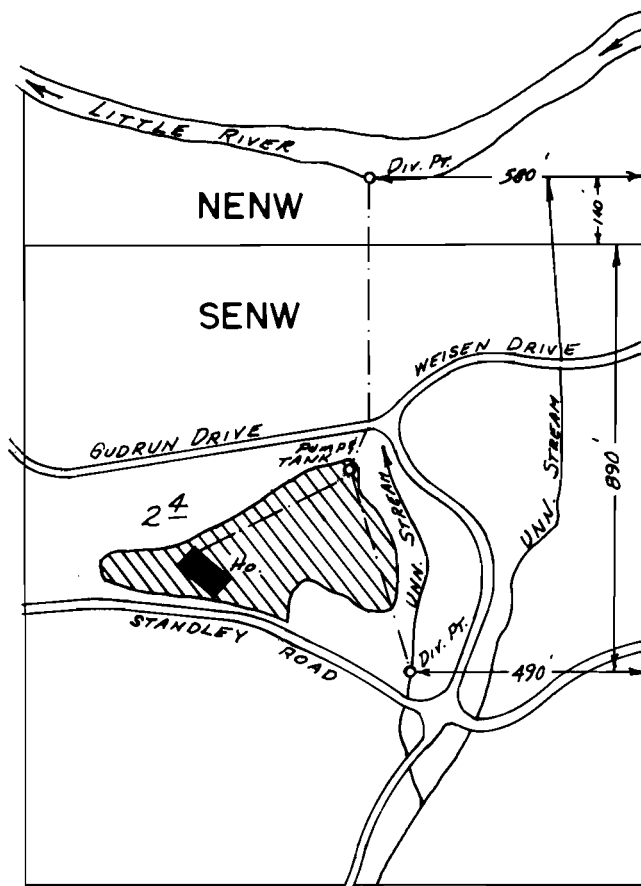

SCALE: 1" = 400'  
**FINAL PROOF SURVEY**  
UNDER

Application No. ~~52949~~.. Permit No. 40299.....  
IN NAME OF

.....**JOHN C. VOLTZ**.....

Surveyed **MAY. 13...** 19.80, by **J.S. DONALDSON**