


T. 26 S., R. 6 W., W.M.

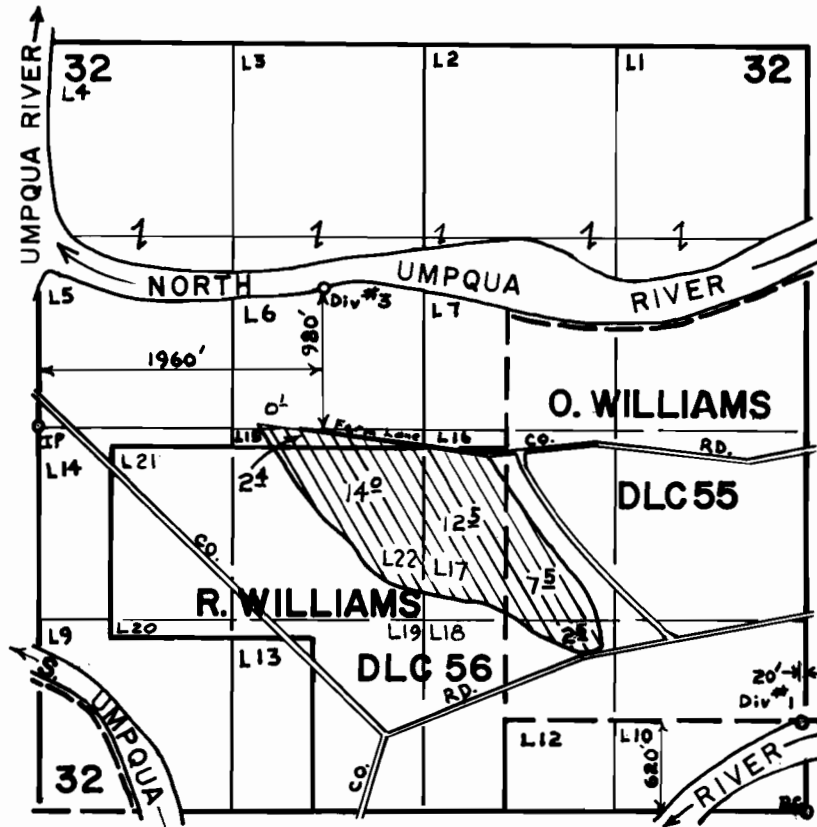

FINAL PROOF SURVEY
UNDER

Application No. 50243.. Permit No. 39113....
IN NAME OF

JOHN S. YOUNG

Surveyed MAY 4... 1978, by D.W. SPARKS...