


44361
51817

T. 40S., R. 1E., W.M.

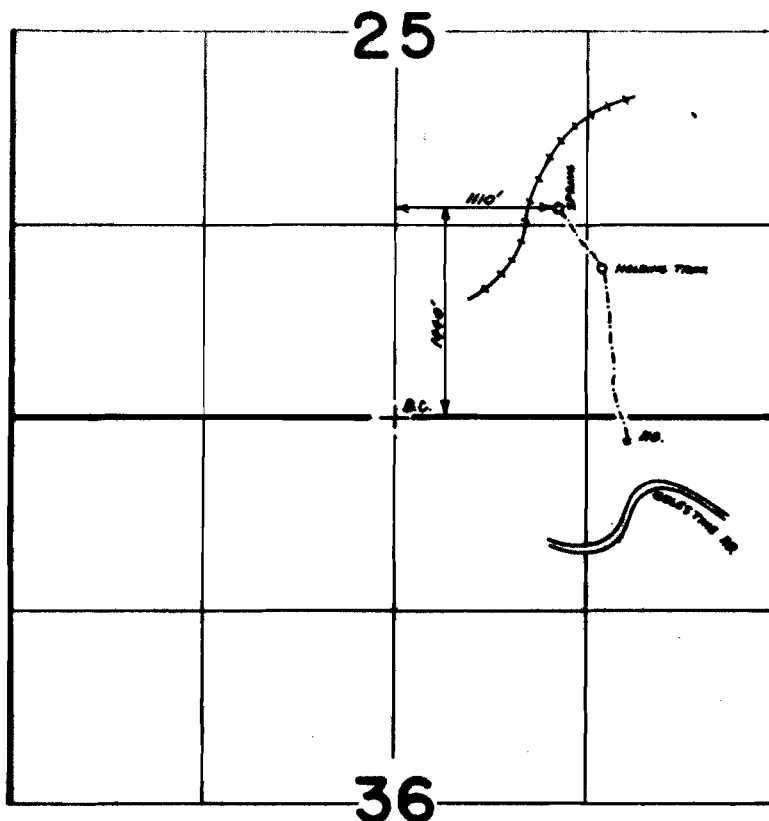

FINAL PROOF SURVEY
UNDER

Application No. **58897**, Permit No. **44361**.....
IN NAME OF

.....**M. L. & Kathryn A. Chappin**.....

Surveyed **Sept. 30, 1983**, by **B. S. JAMES**.....

Scale: 4" = 1 Mile