


T.39 S., R.5 W., W.M.

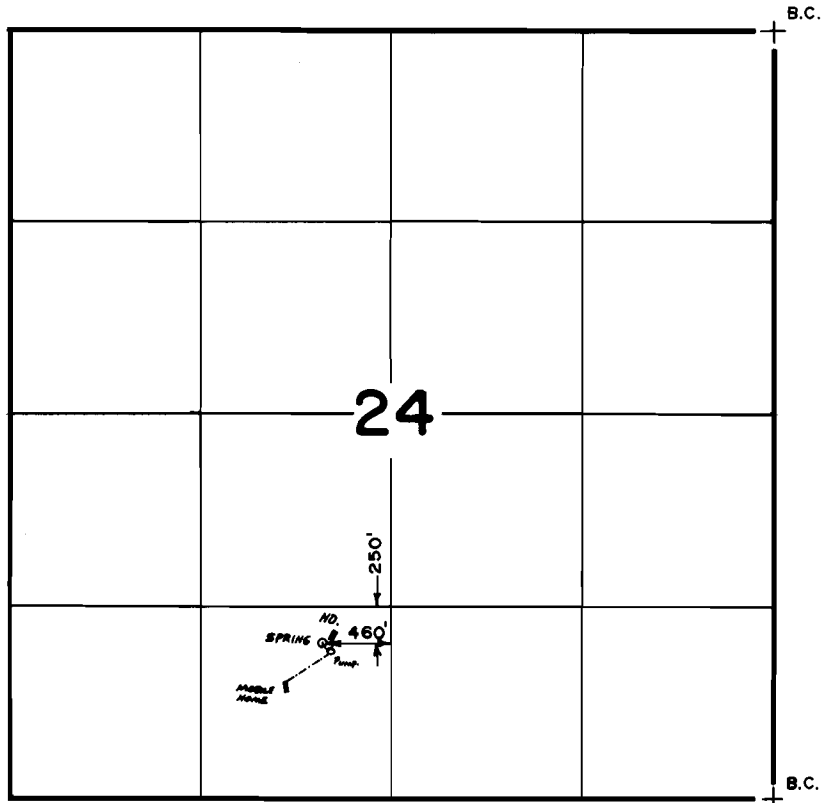

FINAL PROOF SURVEY
UNDER

Application No. **56848** Permit No. **42669**.....
IN NAME OF

...**JIMMY** or **MILDRED** **PASTORE**...

Surveyed **May 13**, 19**82**, by **B.R. SUND**.....

Scale 4" = 1 Mile