


T.IOS.,RIW.,W.M.

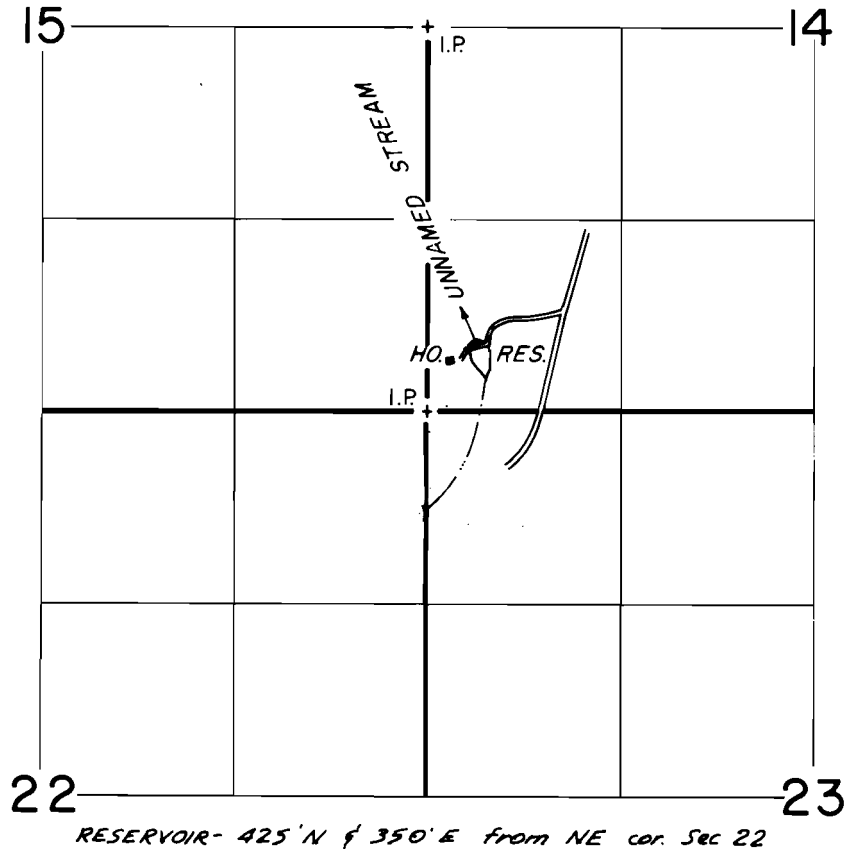

FINAL PROOF SURVEY
UNDER

R-44325 R-5126
Application No. 44326 Permit No. 33101.....
IN NAME OF

.....*Earl W. & Betty J. Shook*.....

Surveyed MAY 1, 1979, by *[Signature]*