


G-8765
51825

T. 2N., R. 33E., W. M.

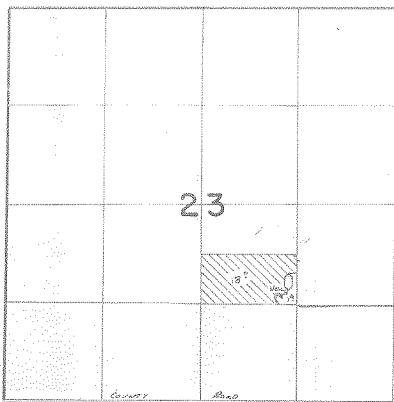

Well Loc. 1510' N. & 1490' W. From SE Cor. Sec. 23

FINAL PROOF SURVEY
UNDER

Application No. **G-9384** Permit No. **G-8765**
IN NAME OF

ROSS **BIRNER**

Surveyed **6-16** 19**83**, by **V. L. Church**