


G-6099

51926

T. 3N., R. 29E., W.M.

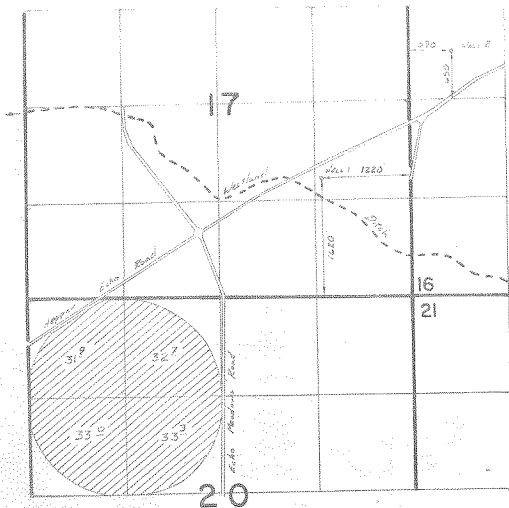

FINAL PROOF SURVEY
UNDER

Application No. **G-6475**, Permit No. **G-6099**,
IN NAME OF

DICK SNOW

Surveyed *May 31*, 19*25*, by *A. H. Church*

1601 9/14/83
71-5785