


T. 5N. R. 36E. W.M.

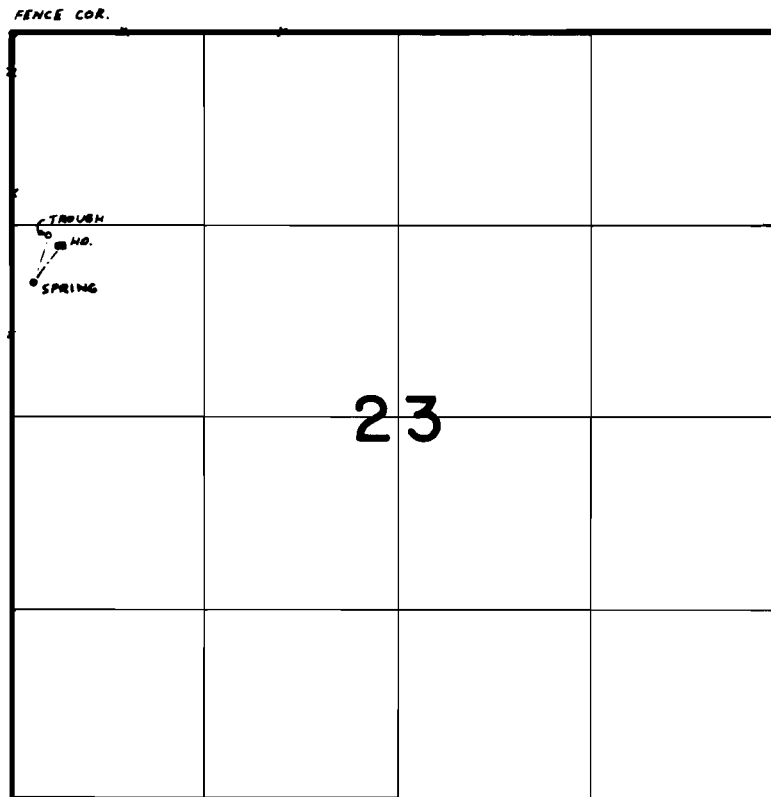

SPRING LOC. 1720'S & 150'E FROM NW COR SEC 23

FINAL PROOF SURVEY
UNDER

Application No. 49140.... Permit No. 36847....
IN NAME OF

.....ROBERT A. TEN EYCK.....

Surveyed 9-21..... 1978., by R. BARWIN.....