


T. 1S. R. 38E. W.M.

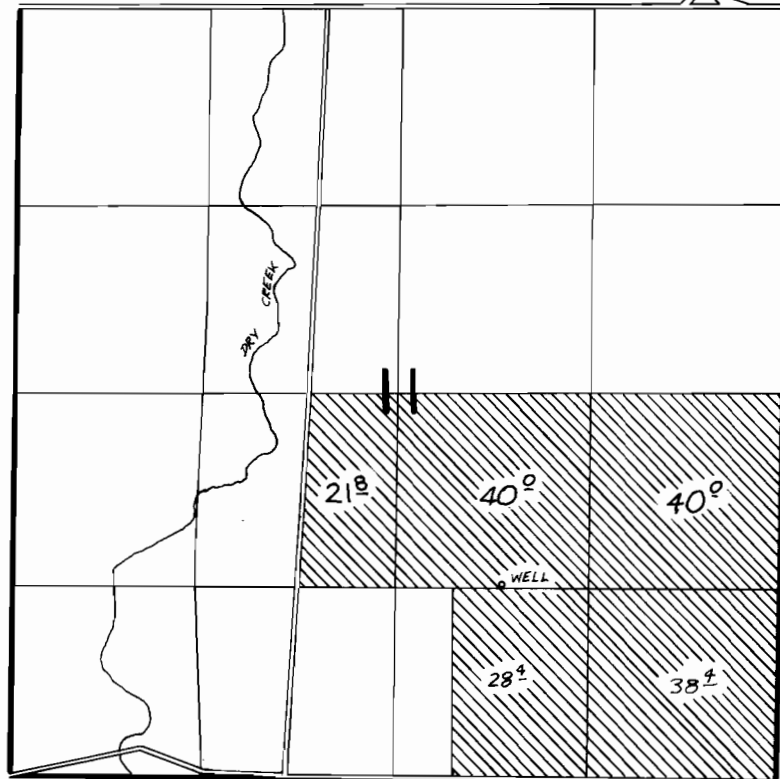

WELL LOC 1350'N & 730'E FROM S1/4 COR SEC 11

FINAL PROOF SURVEY
UNDER

Application No. G-7265 Permit No. G-6855
IN NAME OF

L. R. STARR

Surveyed 6-14 1978, by R. BARWIN