


T. 1S. R. 38E. W.M.

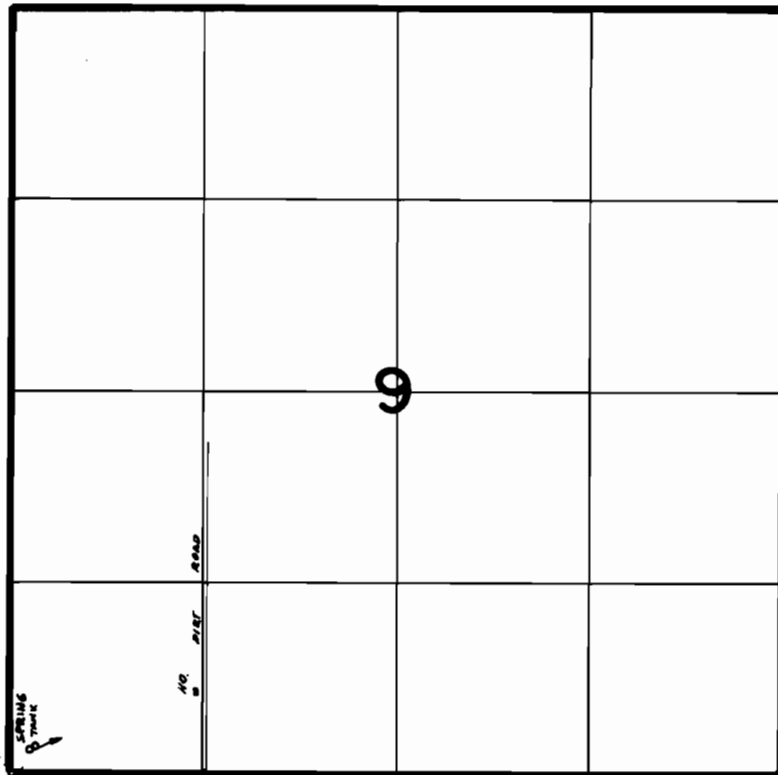

SPRING LOC. 150' N. & 130' E FROM SW COR SEC 9

**FINAL PROOF SURVEY**  
UNDER

Application No. **53740** Permit No. **40358**  
IN NAME OF

**EARL L. & CHRISTINE HOUGHAM**

Surveyed **6-22** 19**78**, by **R. BARWIN**