



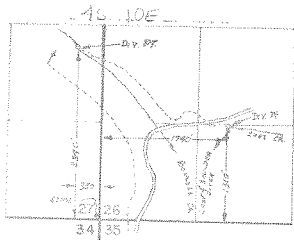

P# 40276

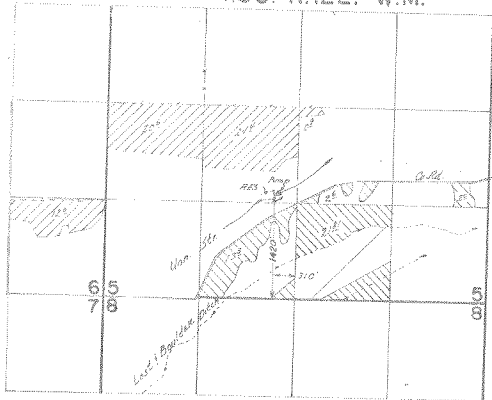

T.5S. R.12E. W.M.



 *Iron from Wan. Str.*

 *Iron from Lost / Boulder Ditch*

T.4S. R.10E. W.M.



SEC. 27  
SW  $\frac{1}{4}$  SW  $\frac{1}{4}$

**FINAL PROOF SURVEY**  
UNDER

Application No. 53655. Permit No. 40276  
IN NAME OF

**DERALD & LINDA WALKER**

Surveyed Sept. 11, 1979, by C.R. RODRIGUEZ

CS-18-6-1-PLS-1979-CR