


T.1N.,R.4W.,W.M.

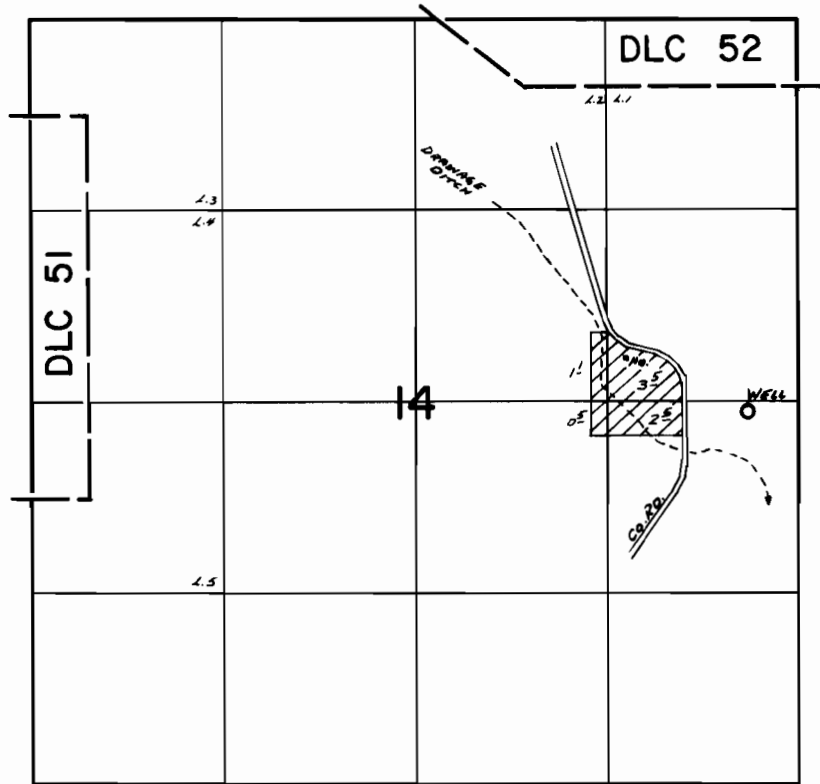

Well Loc: 80 ft. S and 350 ft. W from E 1/4 Cor. Sec. 14

FINAL PROOF SURVEY
UNDER

Application No. G-8871.. Permit No. G-8221.....
IN NAME OF

ROBERT G. & MARGE F. MARTENS

Surveyed Nov... 1983., by L.M.TOLL.....