



T.29S., R.14W., W.M.

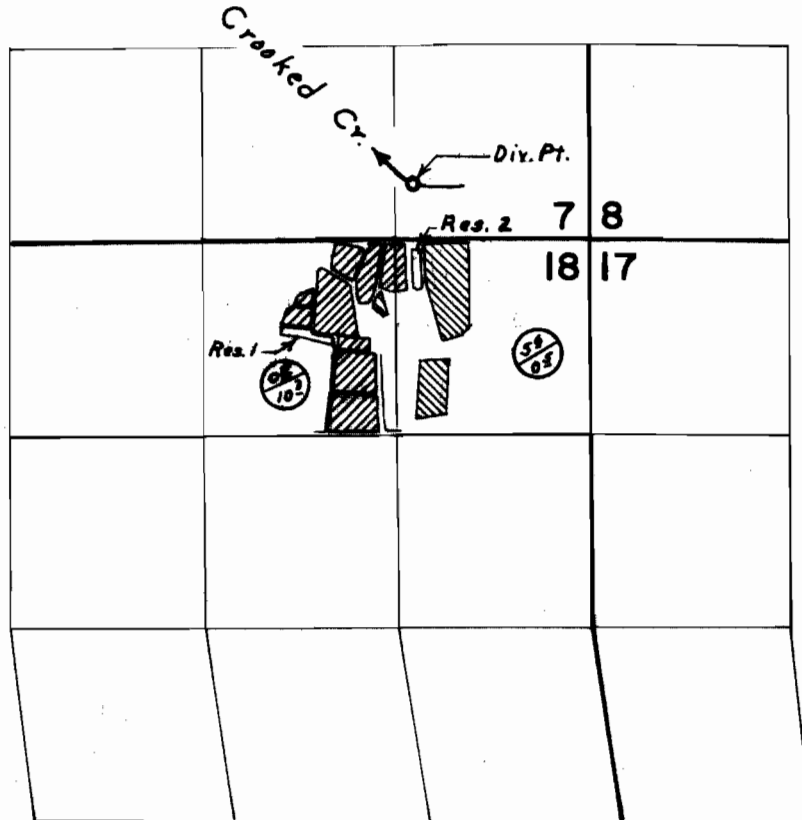

Div. Pt. located: Cr., 380' N. & 120' E.; Res. 1, 650' S. & 680' W.;
 Res. 2, 200' S. & 140' E.; all from N.W. Cor. N.E. & N.E. & Sec. 18

Primary
 Supplemental

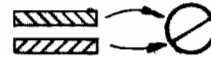

FINAL PROOF SURVEY UNDER

R-45810 R-5431
 Application No. 45811 Permit No. 34185
 IN NAME OF
 MRS. GERTRUDE PEARL TUCKER
 & MR. JAY HESS

Surveyed April 17, 1972, by L. E. Gould.