


T.29S.R.14W.W.M.

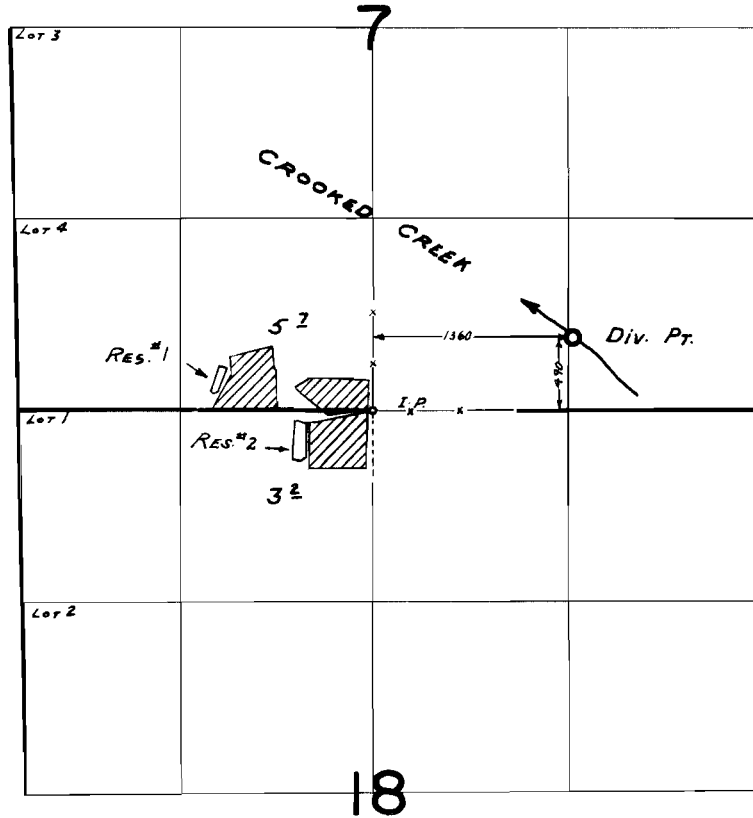

FINAL PROOF SURVEY
UNDER

R-41985 R-4830
Application No. 41986 Permit No. 31786
IN NAME OF
W. R. WARD

Surveyed *MAY 16 1969*, by *W. RUPPERT*