


T.27S. R.2W.W.M.

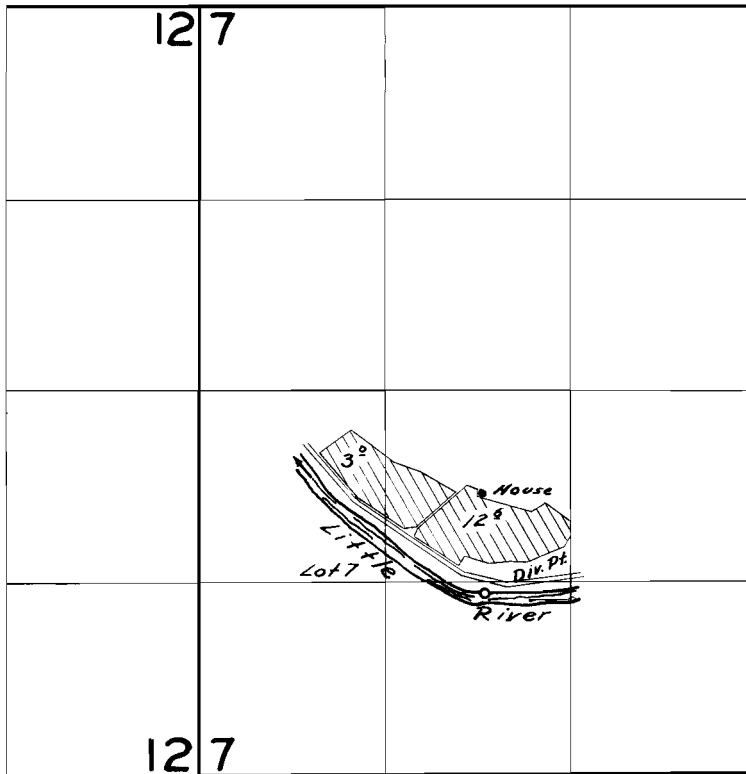

FINAL PROOF SURVEY
UNDER

Application No. 24532 Permit No. 19357
IN NAME OF

William E. Crawford & Son

Surveyed June 12 1956, by *C.O. Bartels*