


T.26-27S. R.3 W.W.M.

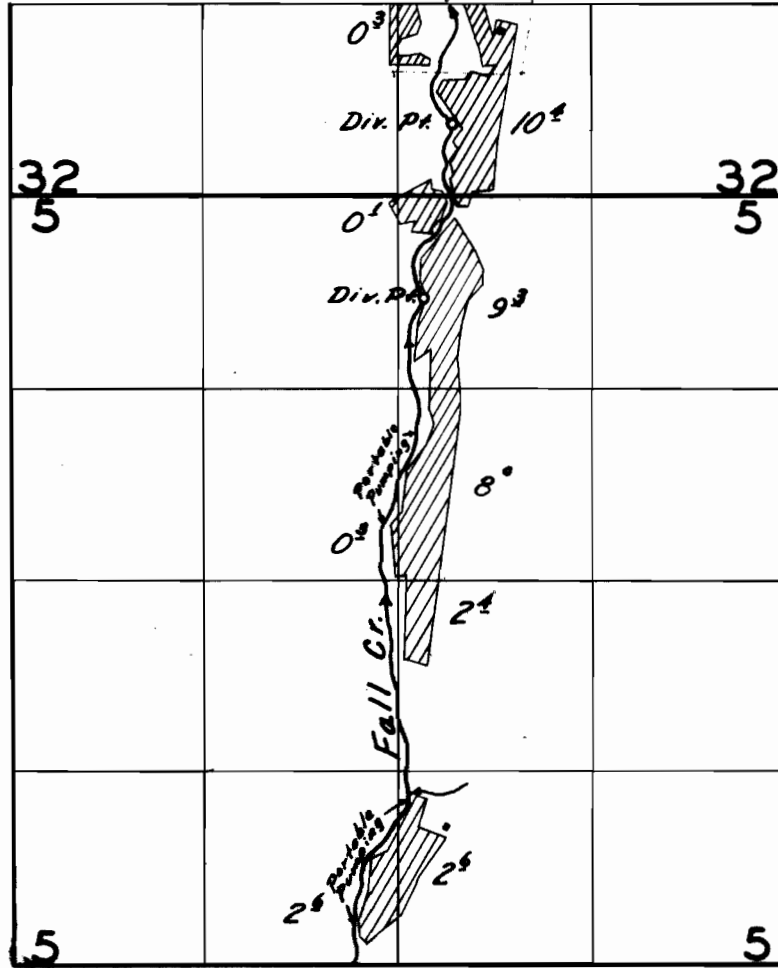

FINAL PROOF SURVEY

UNDER

Application No. *25971*. Permit No. *20687*.

IN NAME OF

L.T. Howard & Paula Heinz.....

Surveyed *June 11*, 1956, by *G.O. Bartels*.