


T.13S. R.29E.W.M.

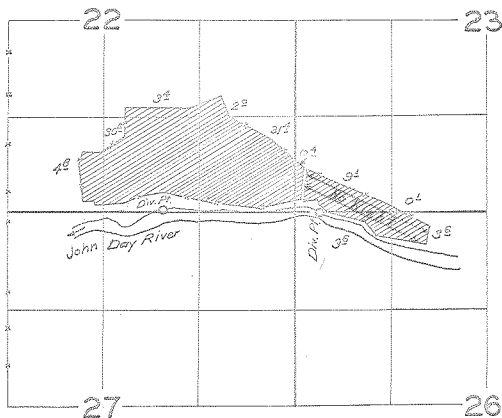

FINAL PROOF SURVEY
UNDER

Application No. 34754... Permit No. 27283.
IN NAME OF

ESTATE OF JOHN CAW RSE...

Surveyed Nov. 15... 1962, by Ralph Jackson

Carline Martin