


T. 15S., R. 12W., W.M.

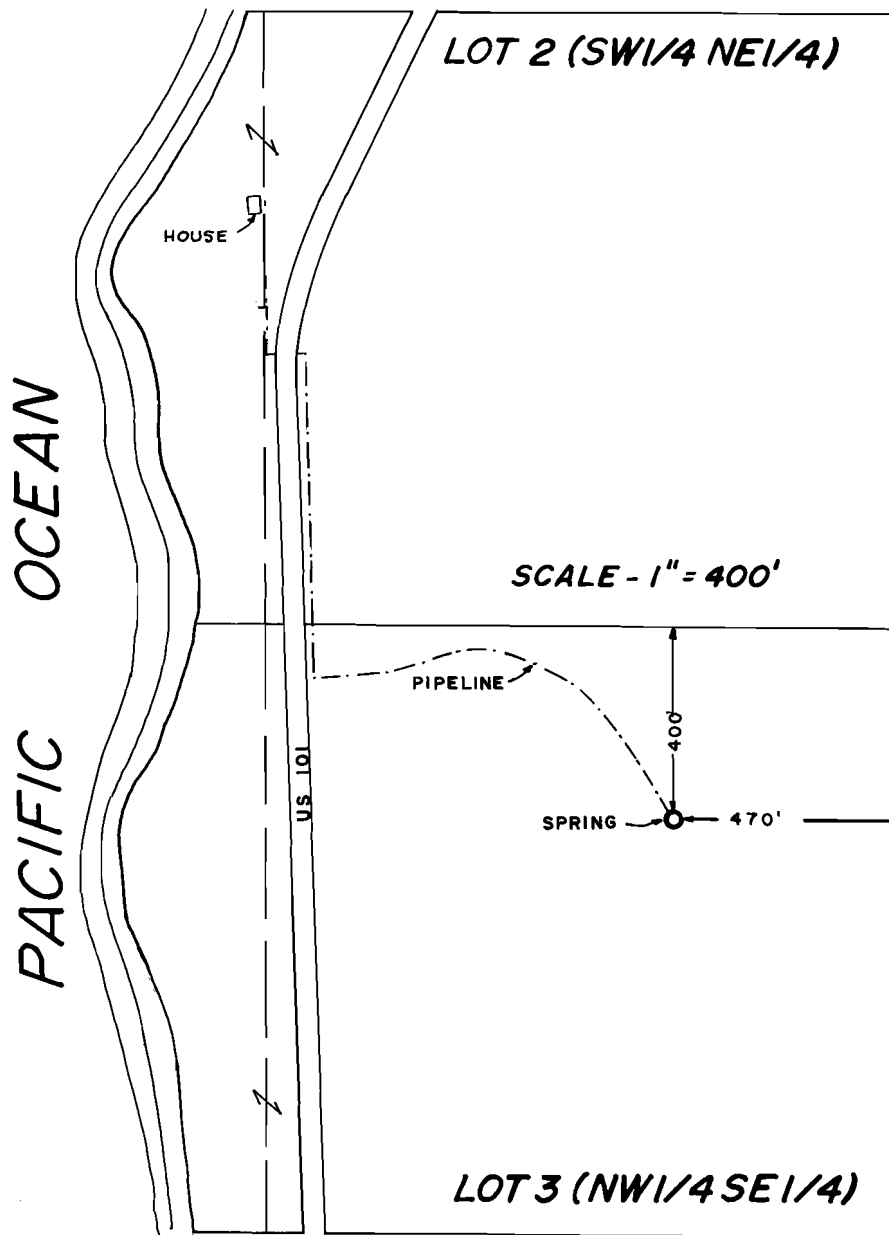

SECTION 34

SCALE: 1" = 400'

FINAL PROOF SURVEY
UNDER

Application No. **54514**.. Permit No. **40676**....
IN NAME OF

NORMAN E. WILDISH

Surveyed **AUG. 7**.... 1979, by **S.C. BROWN**.....