T. 34 S., R. 3 W., W. M.

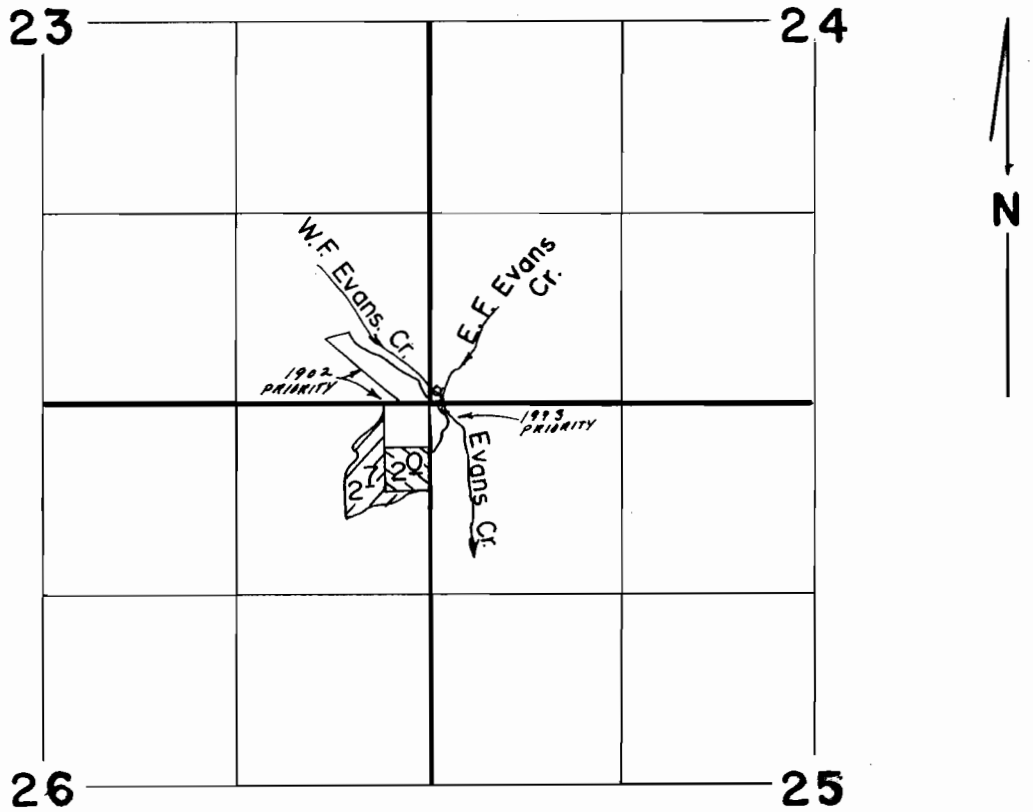

Scale: 1" = 1320'

1940

1973

FINAL PROOF SURVEY
UNDER

TRANSFER NO. 5182

Application No. ..... Permit No. .....

IN NAME OF

TIMM A. HARRIS & URSULA NADOLNY

Surveyed JUN....3... 19.87., by B....S....JAMES....