


~~F5412~~
 G-1388
 C# 56503
 Transfer# 5412
 51863

T.30S.,R.16E.,W.M.

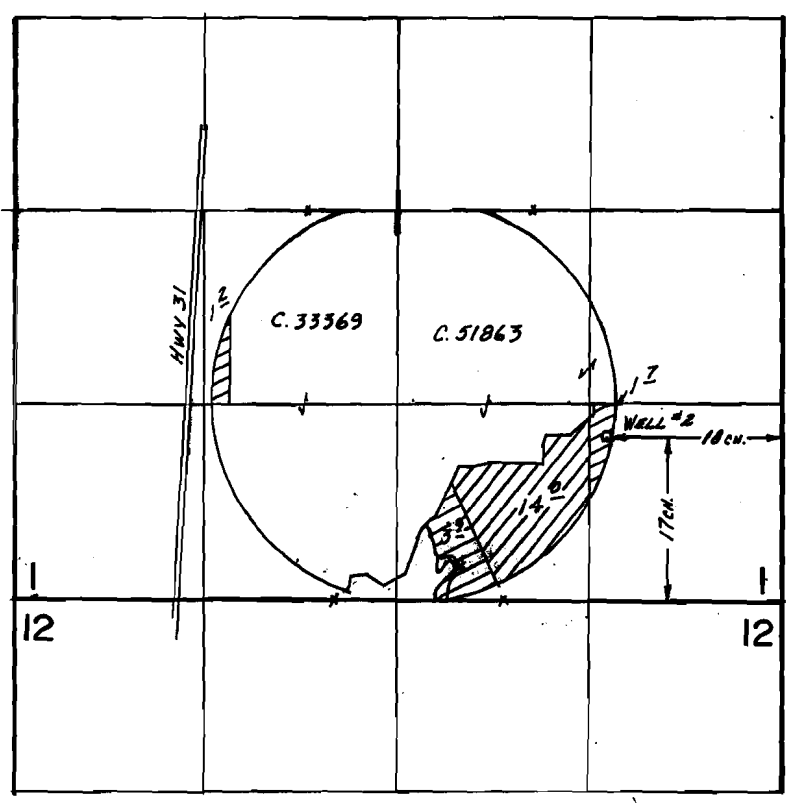

 Tr. 5412
 G-11199
 SCALE: 1" = 1320

FINAL PROOF SURVEY
 UNDER

Transfer No. 5412
 Application No. G-11199 Permit No. G-10293...
 IN NAME OF

.....WITHERS RANCH, INC.....

Surveyed Oct. 14, 1985, by R.W. BISHOP.....