


(7-5111)

38092
44007
51865
57543

TS238

T.26S.R.15E.W.M.

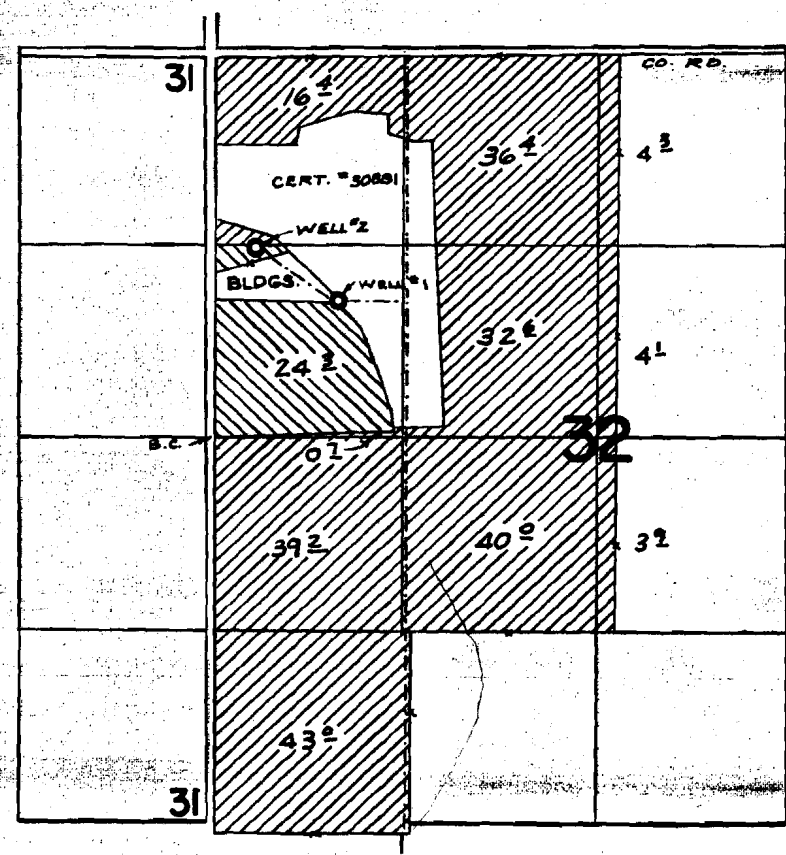

PRIMARY SUPPLEMENTAL

FINAL PROOF SURVEY UNDER

Application No. G-3291 Permit No. G-3020
IN NAME OF

ROBERT R. TUTTLE & ESTATE OF GERALDINE TUTTLE

Surveyed JUNE 23, 1970, by R. MUCKEN