


RECEIVED

APR 19 1983  
WATER RESOURCES DEPT.  
SALEM, OREGON

F-5246

T0 1111

Appl. No. 11212  
Per. No. 7690

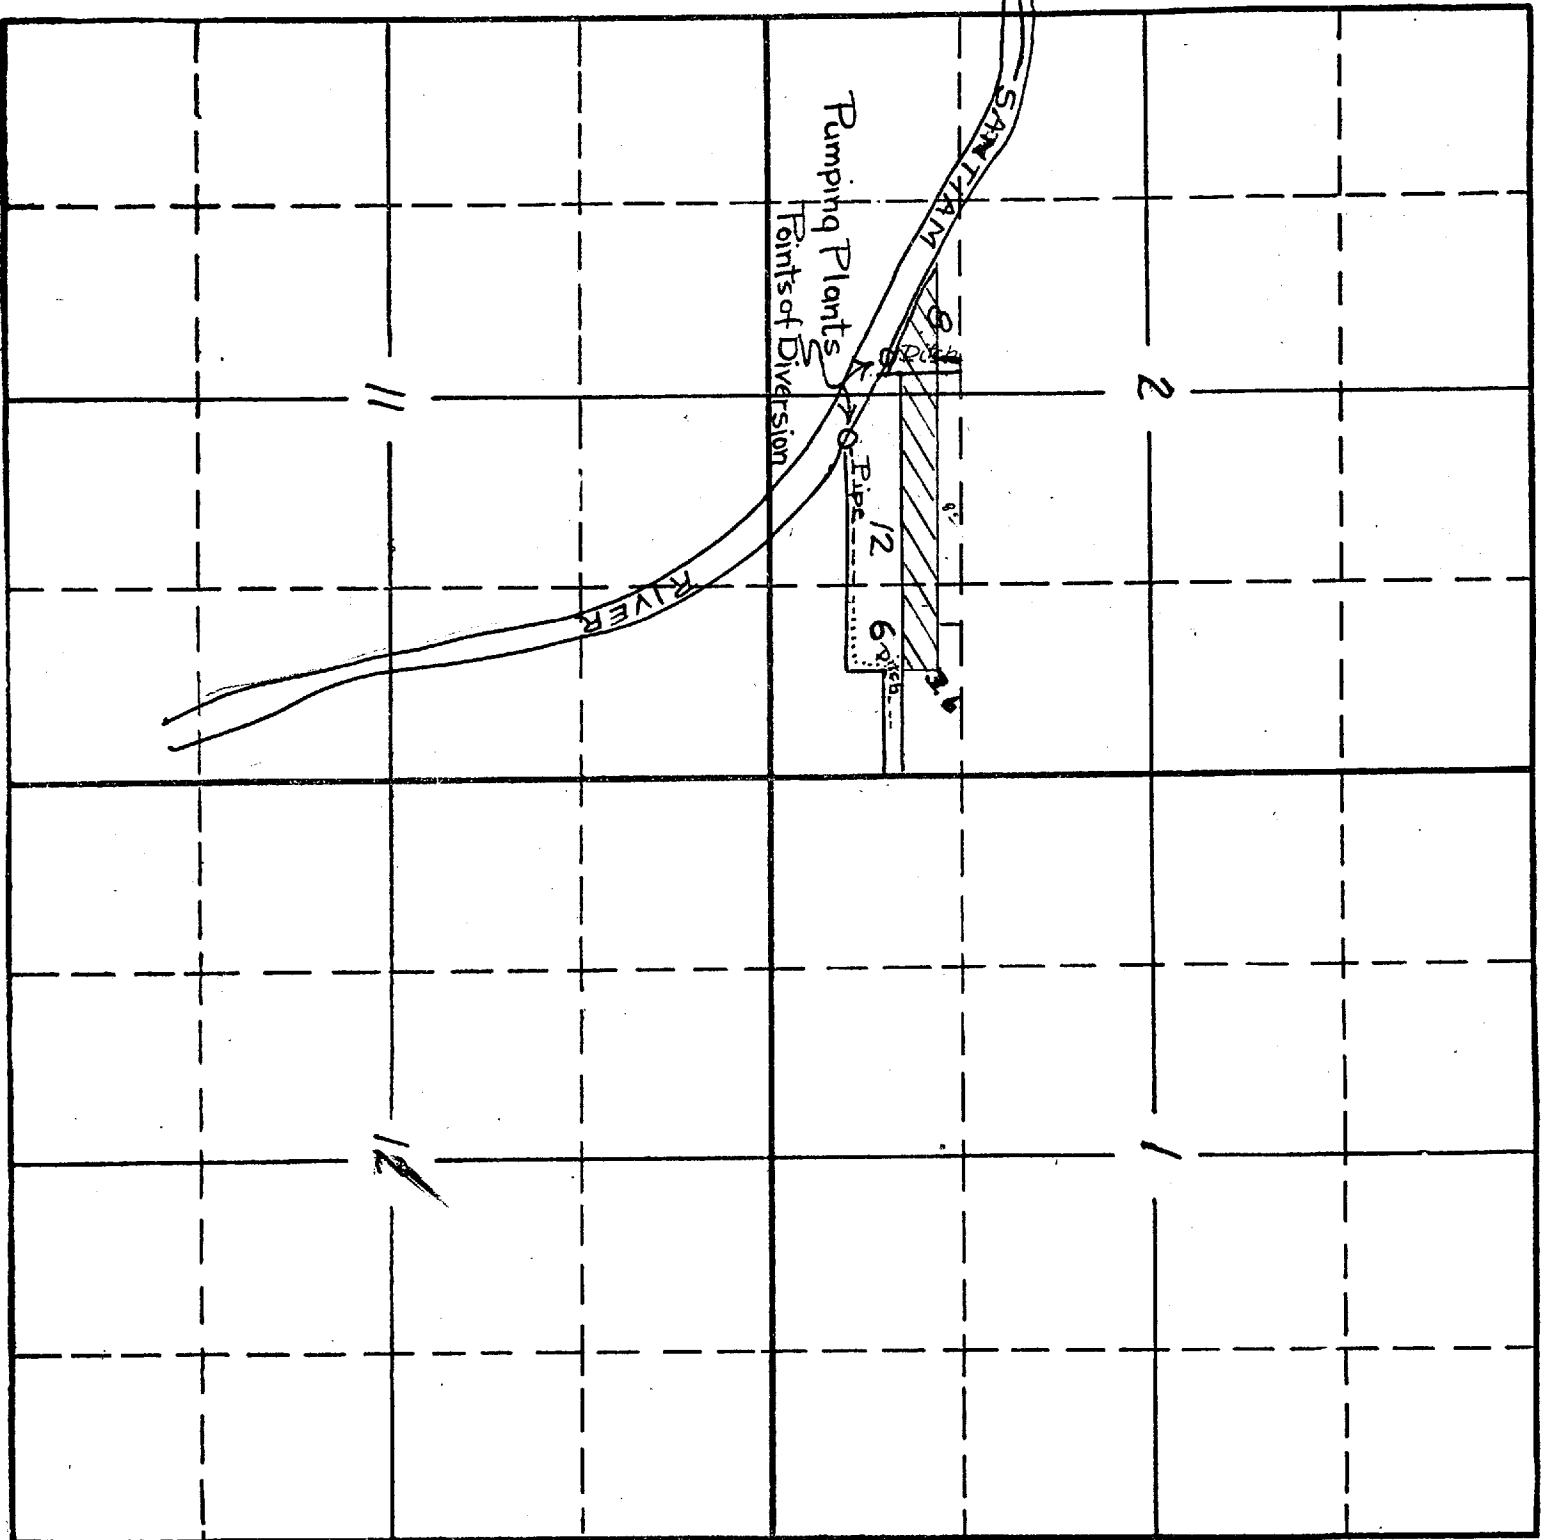

Sec. 1  
2  
11  
12  
 Tp. 10 S  
 R. 3 W