


T. 7 S. R. 4 W. W.M.

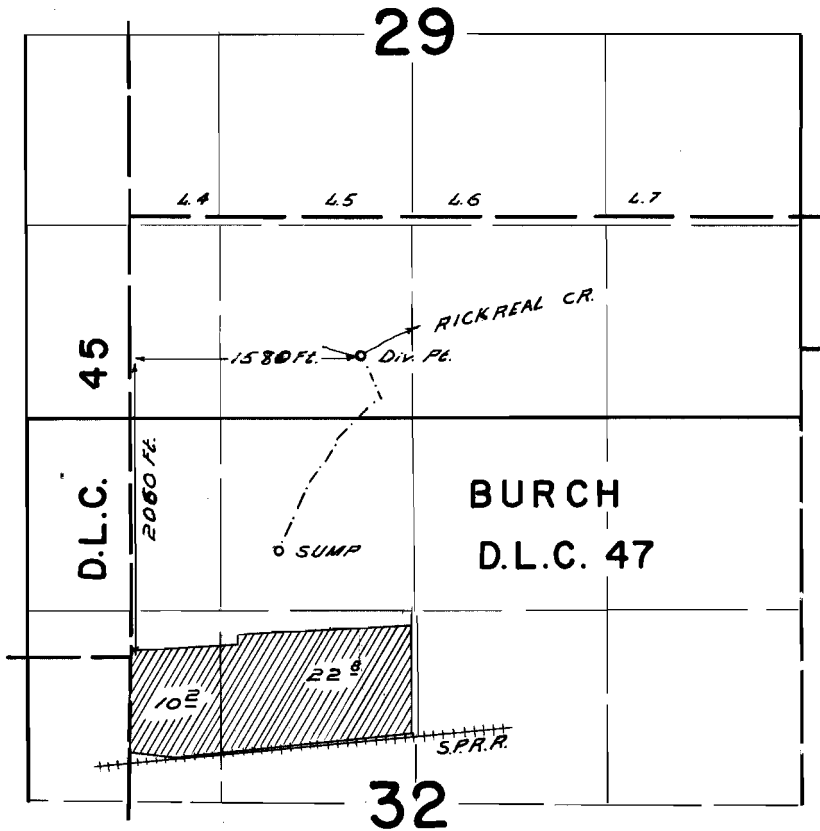

FINAL PROOF SURVEY
UNDER

Application No. 39975 Permit No. 29745
IN NAME OF

C. BARENDRECHT

Surveyed JULY 28 1965, by C. GARDNER.