

6

5

7


8

18

17

21

22

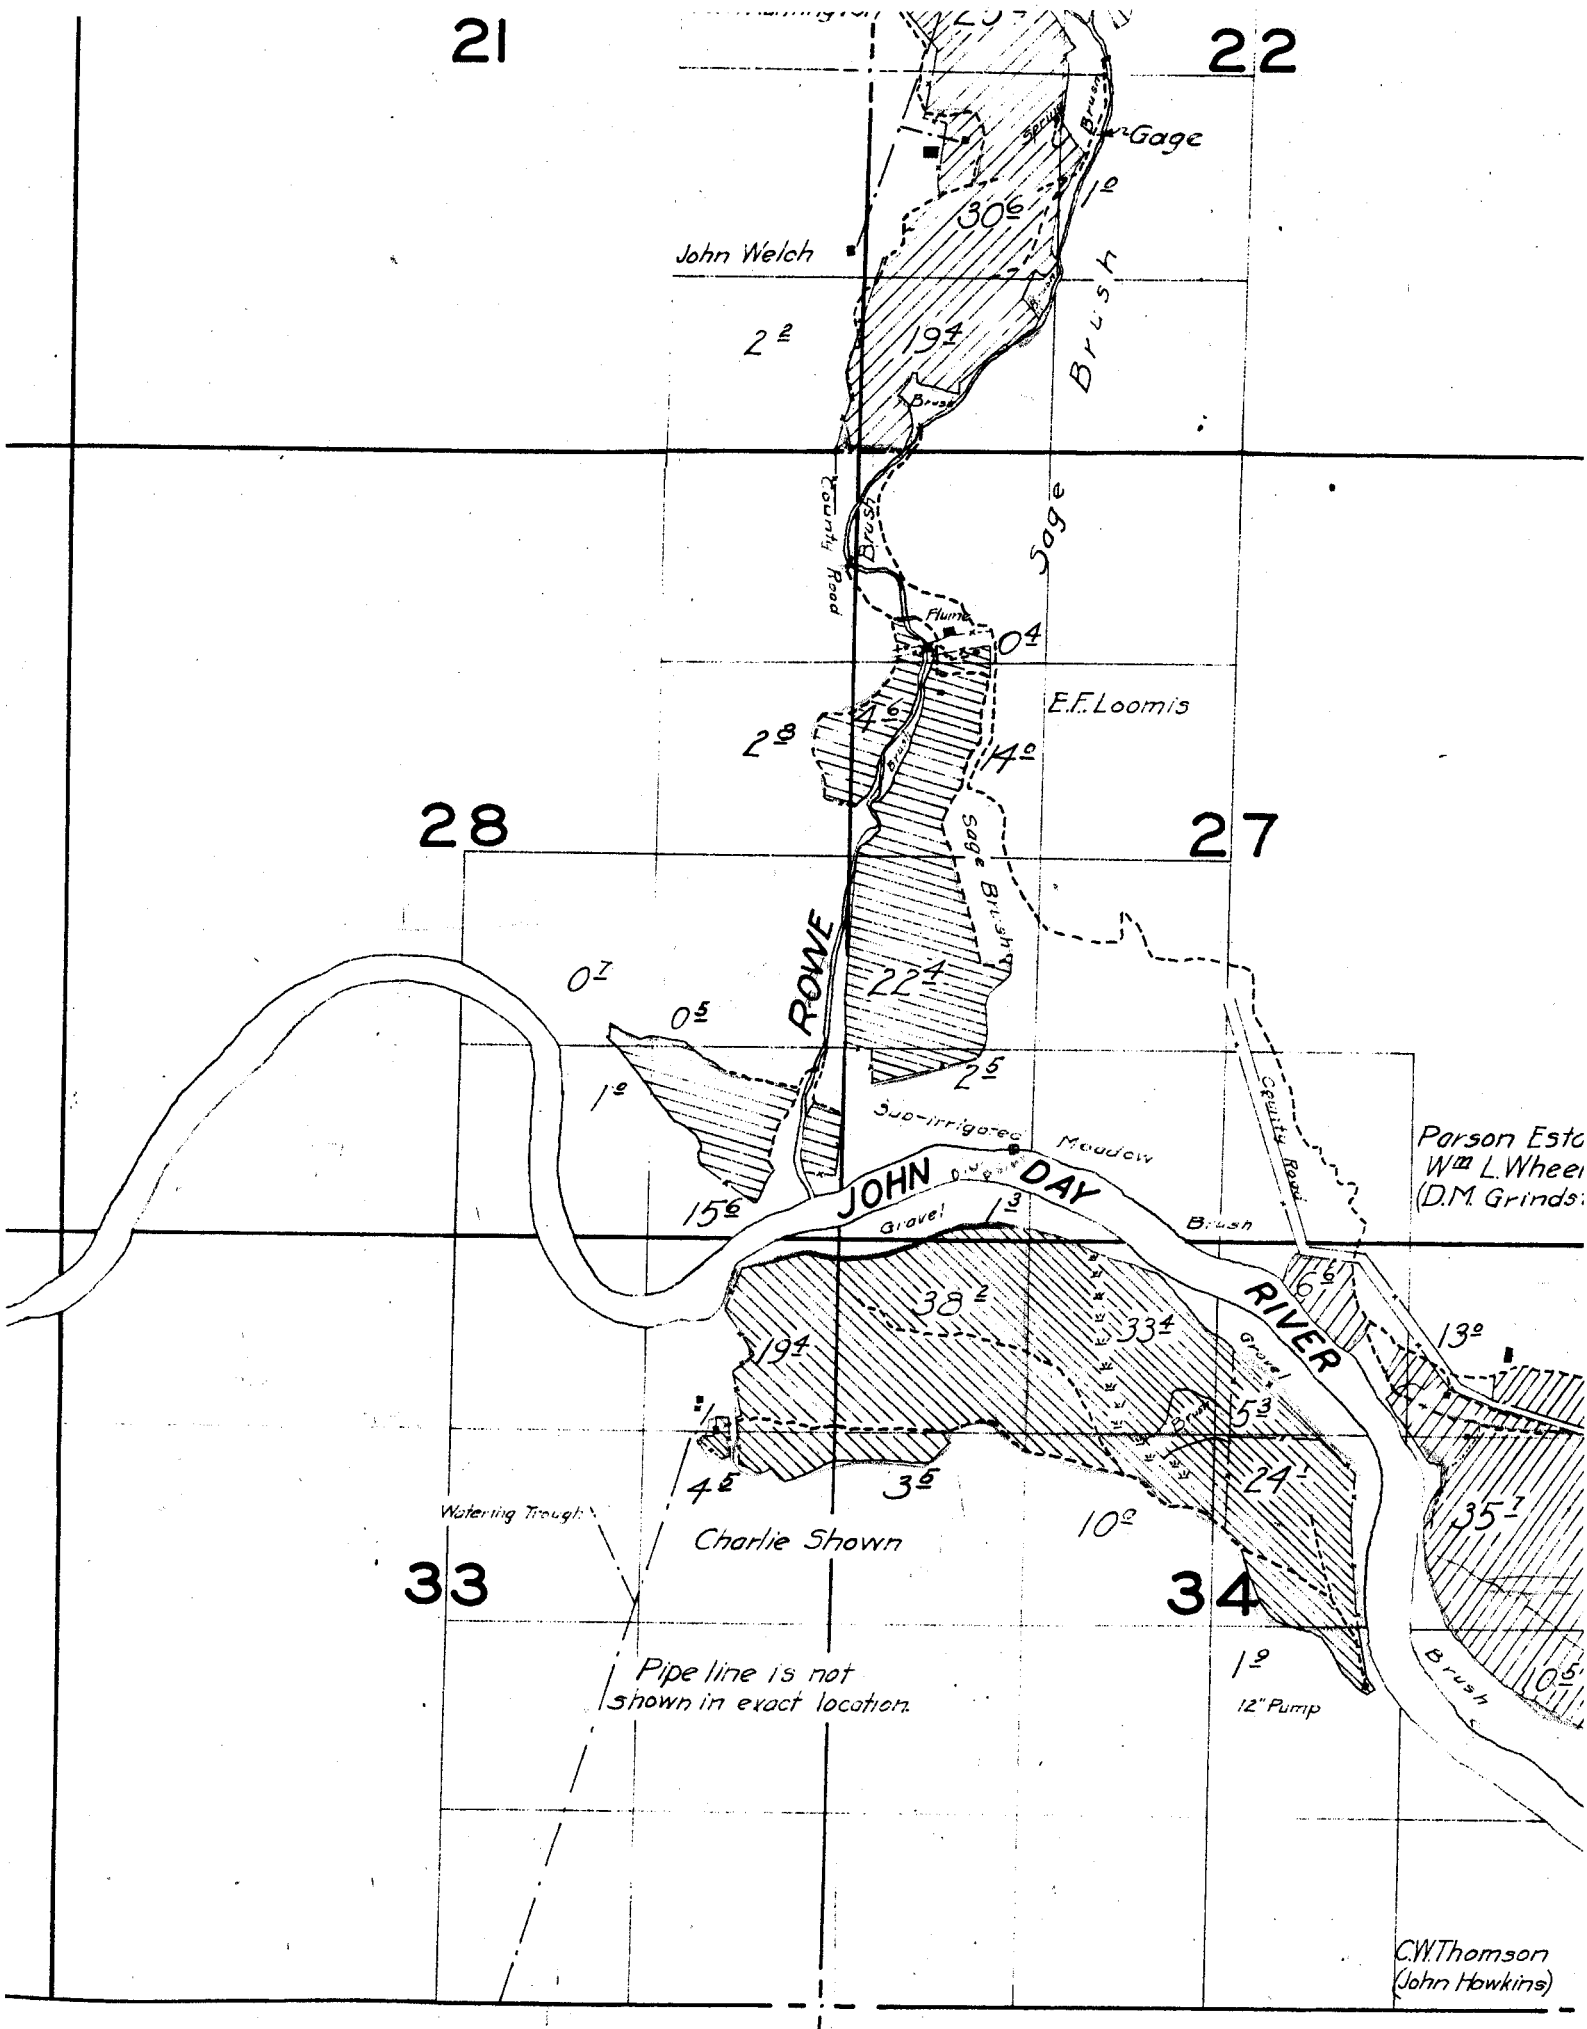

56-2-2

2

1

11

12

84

02

04

Spring
Reservoir
C.C. 3.5'

13

Junipers
Sage Brush

Note:— Location of pipe
line sketched in field.

14

13


TOWNSHIP 9 S., RANGE 21 E.


4

3

9

10

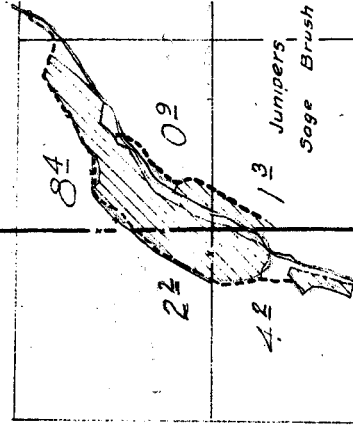

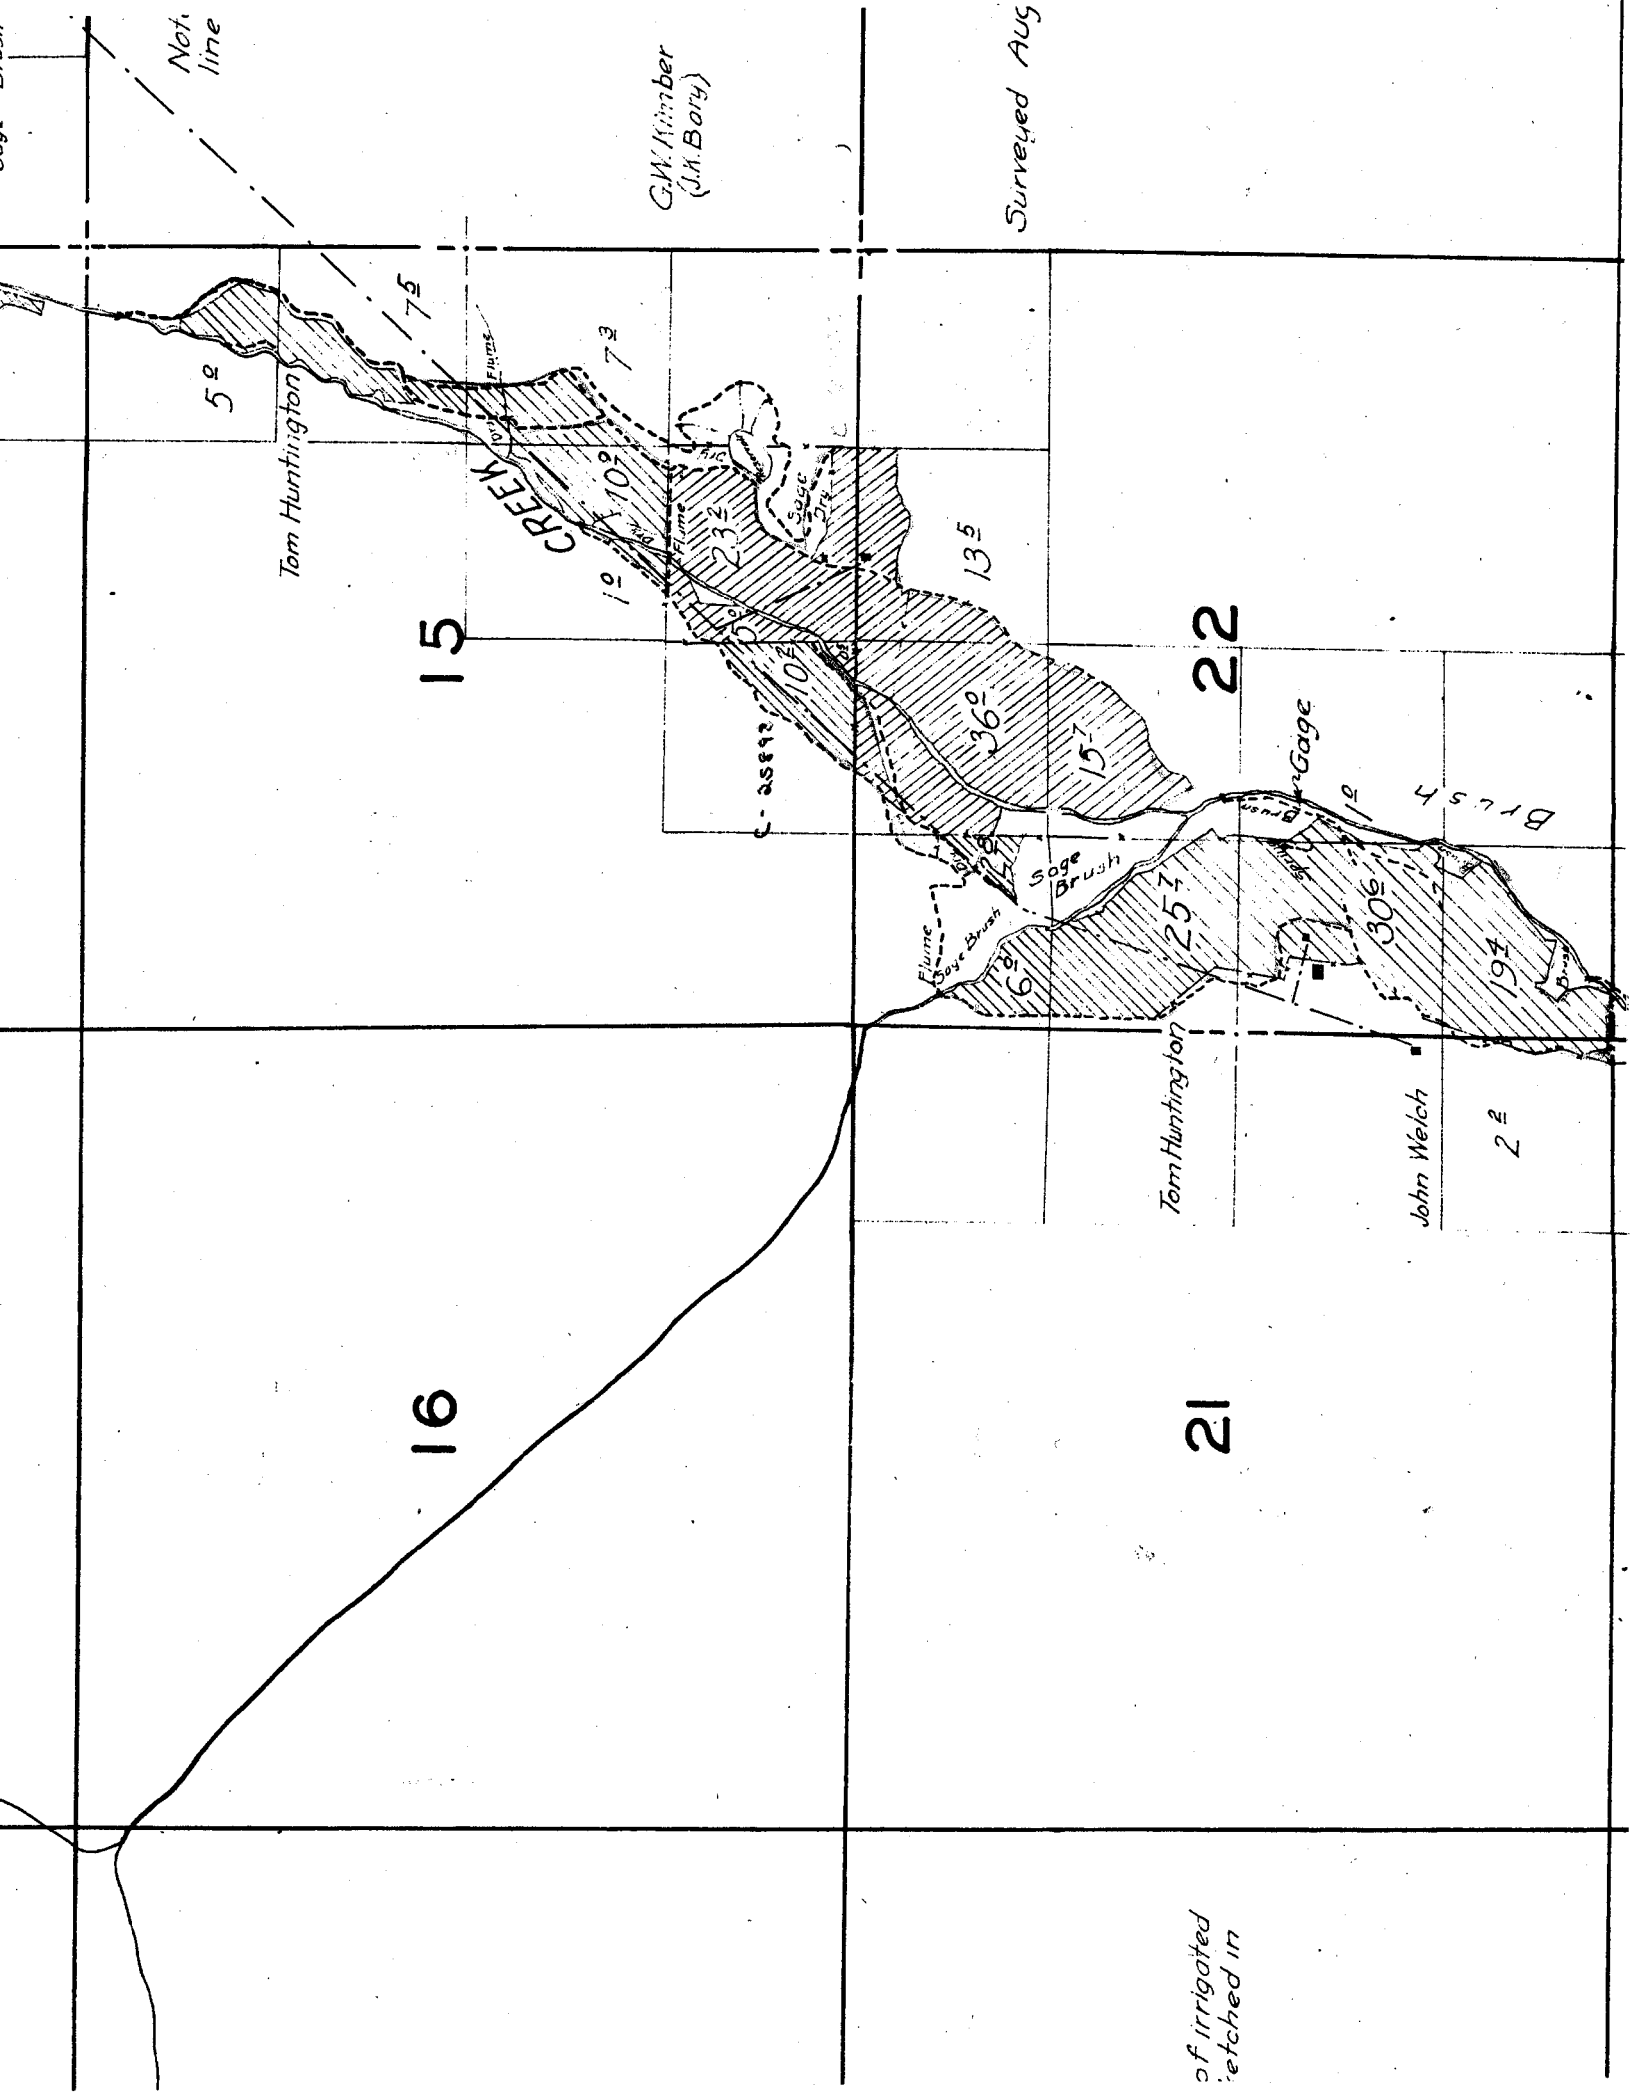

30

29

28

31

32

33

Watering



18

17

16

19

*Note: Except in the vicinity of irrigated
lands streams and river are sketched in
approximate locations.*

21

27

26

25

Parson Estate
Wm L. Wheeler
(DM Grindstaff)

Spring
Reservoir
616134

Pipe line is not
show in exact location.

Joe Chapman

Henry Keys

TWICKINHAM

36

34

12" Pump

School

JK Barry

CW Thomason
(John Hawkins)

JAMES CANYON

Tom Huntington

—4


G.M. Kimber
(J.M. Bory)

Surveyed Aug. 30, & 31, & Sept. 1, & 2, 1926.

22


24

72