


# T.8&9S.R.24&25E.W.M.

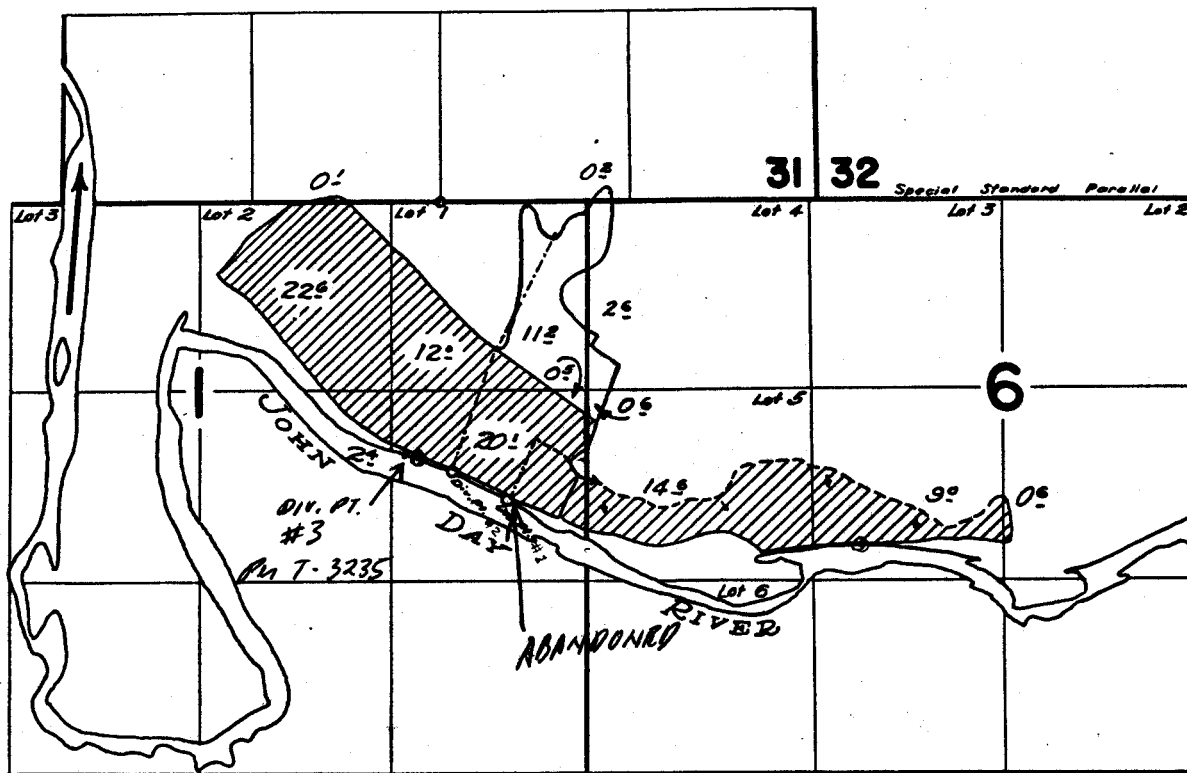

## FINAL PROOF SURVEY UNDER

Application No. 32846.. Permit No. 26002.  
IN NAME OF

WILLIAM I. CHAPMAN

Surveyed Oct. 11. 1961., by C. O. Bartels.