

21

22

4°

7°

3°

Spring

L.H. Donovan

1 1/2
CREEK

1/2

4°

HAYSTACK

Bob Wright

J.F. Asher

28

27

Spring

17°

Surveyed Sept. 19 to 23, 1926

Steiner

5°

C.W. Walls

1°

A.E. Cress

1/2

33

34

40°

Now C-35285

27°

0°

3°

Pump

P.H. Jenkins

6

5

7

13

03

8

uge 8^e
E.R. Moore

07

4^o

A.S. Borges

18

17

2

1

11

12

14

13

30

29

28

HAYSTACK

Spring

172

Bob Wing 54

Surveyed Se

River

31

Surveyed Sept. 29, 1925.

*First National Bank
London*

Oct. 03

32

Can Wagner

L.L. Steiner

16

34

20°

263

28°

C.W. Walls

1/6

3

3

3

SOVI PTH

SOVI 12

ADD.

138

40

27

21

33

07

Puldenhins

Pump

sl

First Nation
Condom 05

Surveyed 56

28
C.W. Walls
1/5
33
+ 50 V. 12.5
Add.










 11

ω

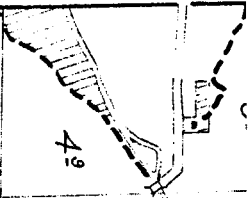

A.5 Borges

18

17


16

19

20

21

Note: Location of streams and roads, except in the vicinity of irrigated land, is sketched in approximate location.

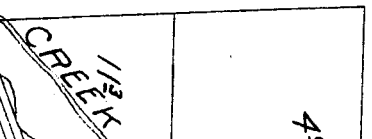

Surveyed Sept. 29, 1985.

Palm Cr.

27

26


25

34

35

36

TOWNSHIP 8 S., RANGE 25 E.

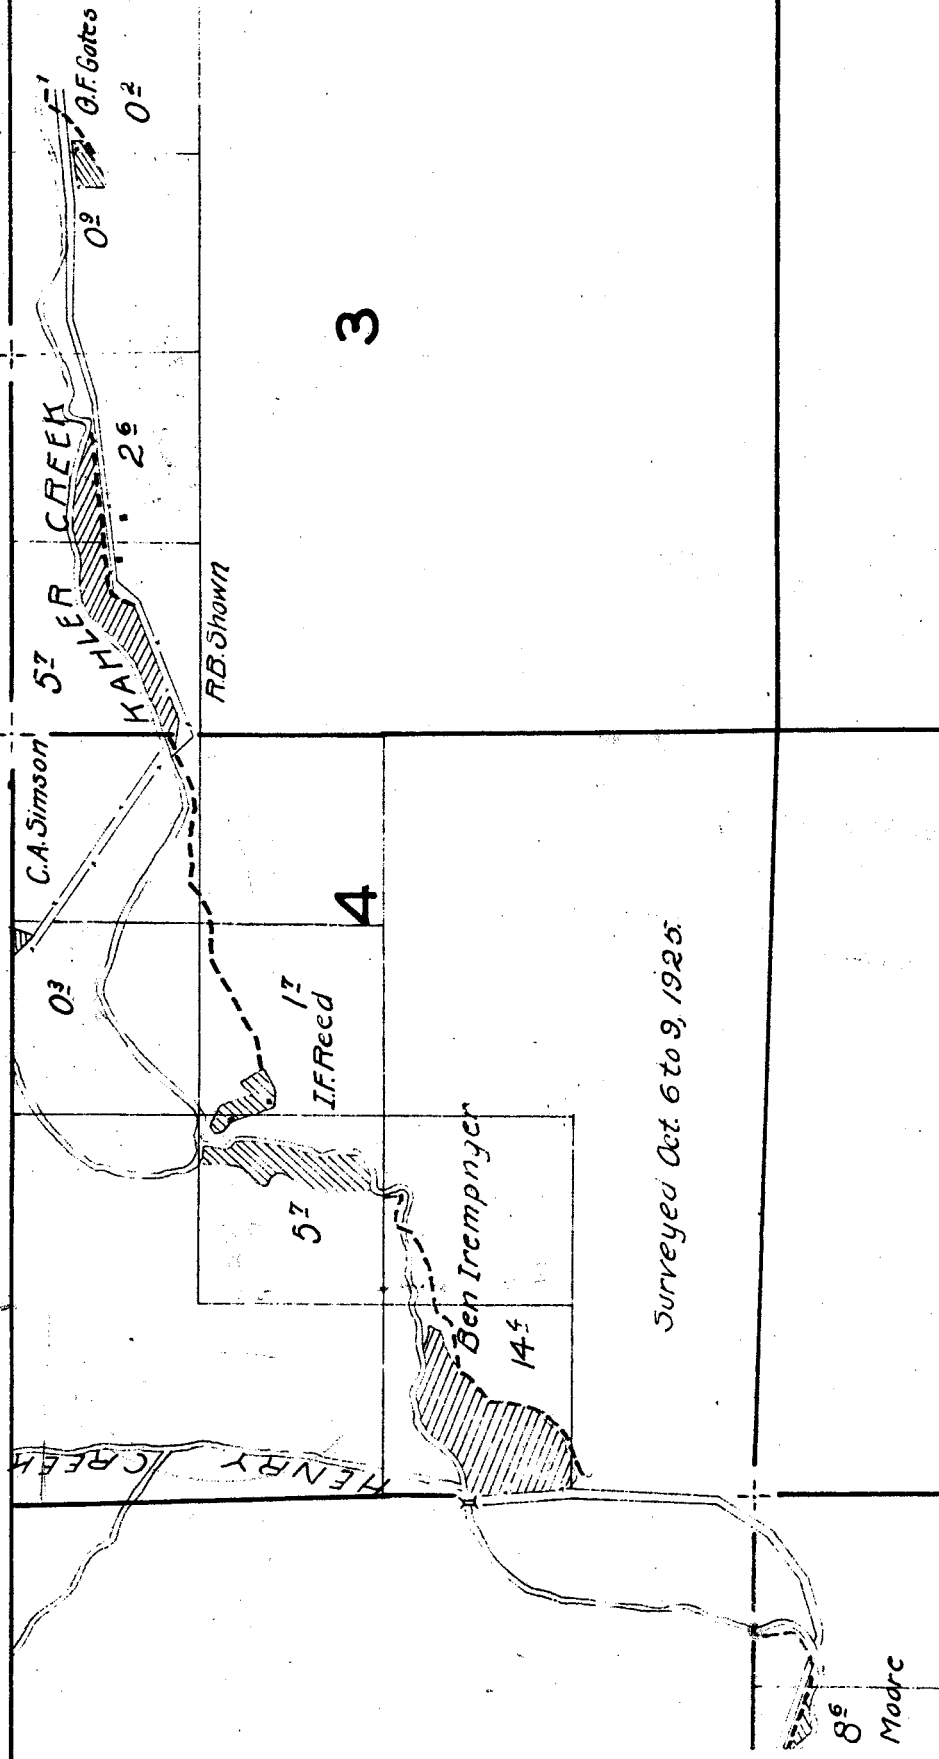

15

16

22

21

L.H. Donovan

35

Spring

40

75

12

112

ds, except
nd, is
ation.

15

14

13

22

23

24

IVES CREEK

02

62

RIJ Carsoner

17

05

