


T.5 S., R.3 W., W.M.

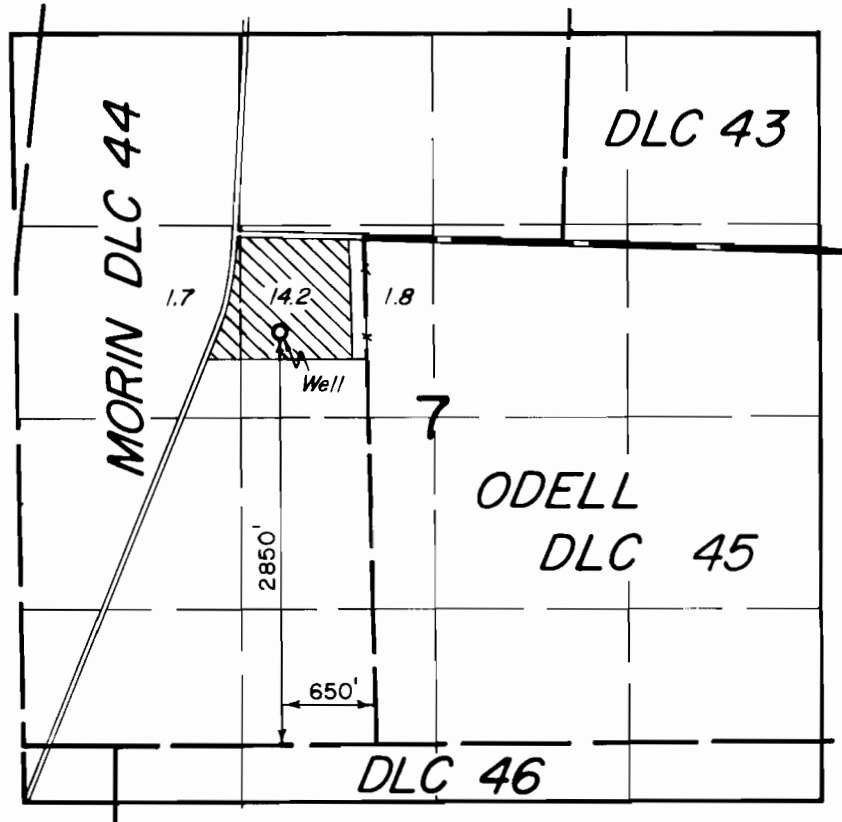

FINAL PROOF SURVEY
UNDER

Application No. G-5569 Permit No. G-5435...

IN NAME OF

RAYMOND W. HINDS

Surveyed MAY 30, 1979, by *[Signature]*