


# T. 35 S., R. 2 W., W.M.

## SEC. 15

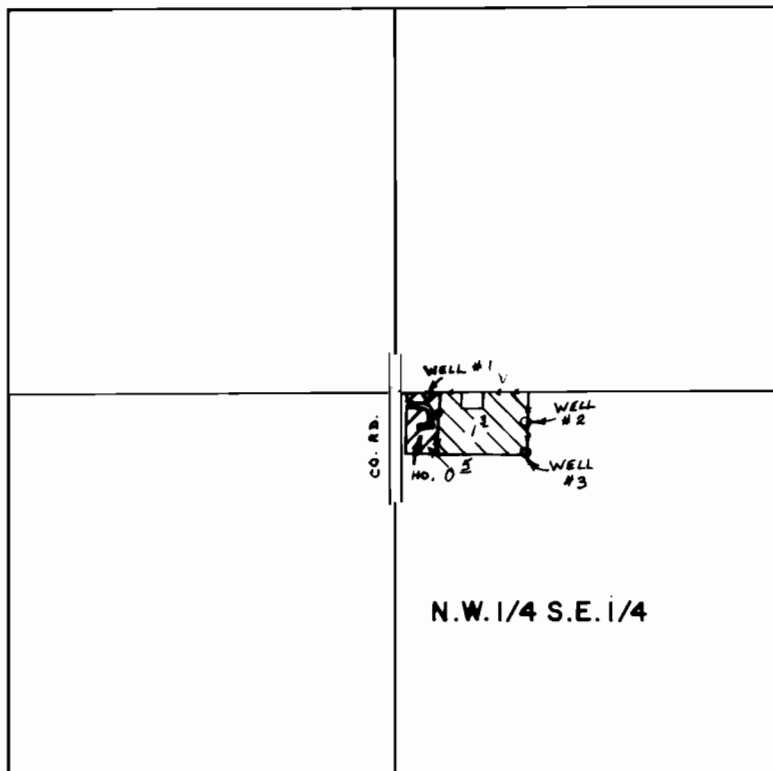

WELL #1 LOC. 10'S. 110'E., "2 110'S 4 440'E, "3 210'S 4 440'E all from  
SCALE : 1" = 660 FT. c/4 cor Sec. 15

 Wells "2 & "3       Well #1

### FINAL PROOF SURVEY UNDER

Application No. G-6088 Permit No. G-5772

IN NAME OF

C. J. OR DORIS KELLEY

Surveyed APR. 12 1978, by B. SUND

D.H.M.  
P.T.S.-1978-14-A