


# T.7S. R.2W., W.M.

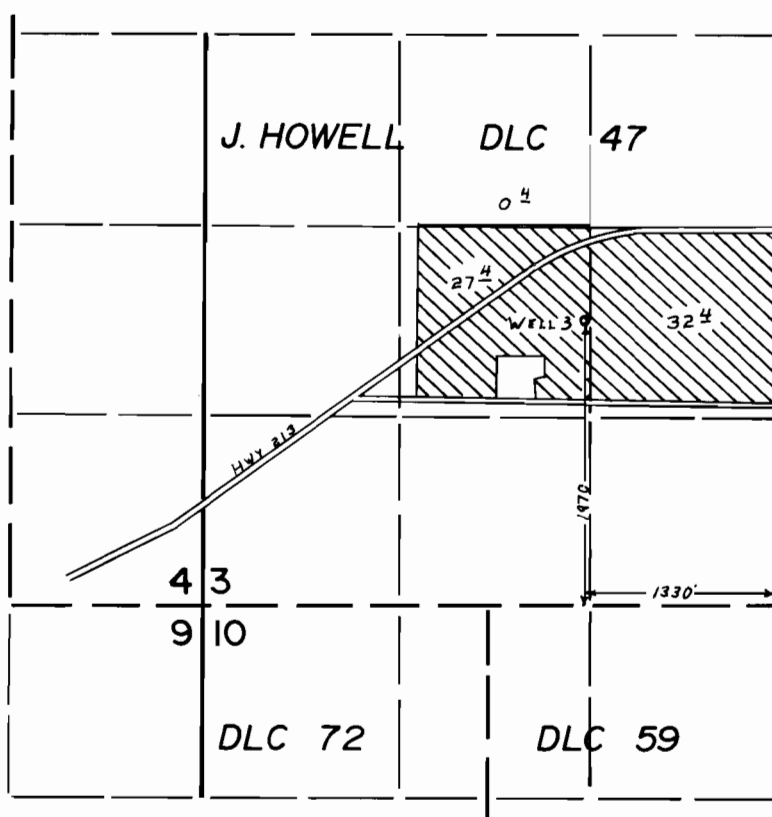

## FINAL PROOF SURVEY UNDER

Application No. ~~G-6456~~ Permit No. G-6055.....  
IN NAME OF

.....DAN HAURY.....

Surveyed MAY 17 1979, by L. H. NUNN.....