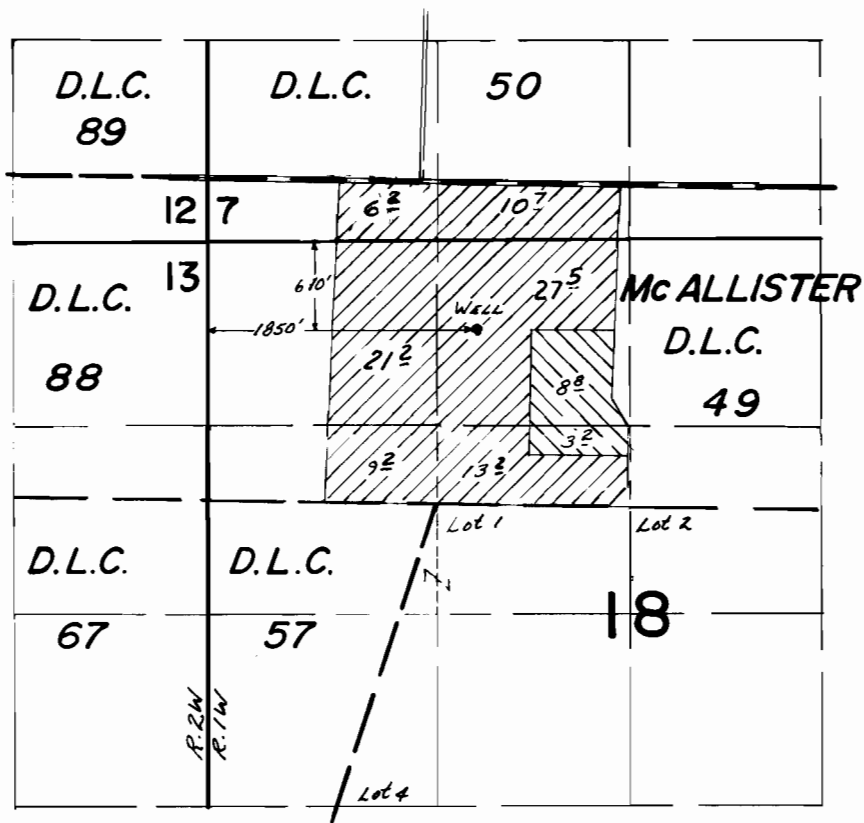

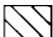


T. 7S. R.1W. W.M.



 - PRIMARY
 - SUPPL.

FINAL PROOF SURVEY UNDER

Application No. G-6799 Permit No. G-6307.
IN NAME OF

MELVIN E. KING

Surveyed Oct. 5, 1979, by C.R. RODRIGUEZ.