


G. 6817
51895

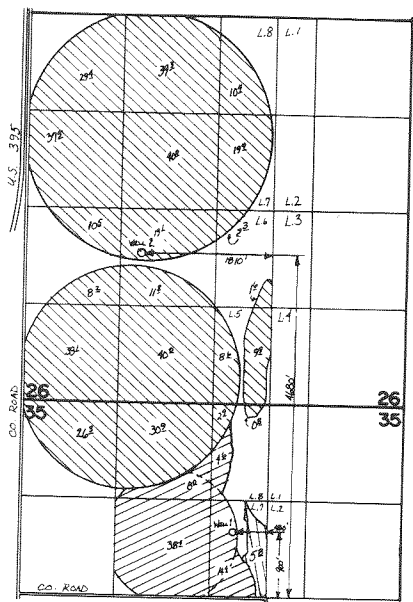

FINAL PROOF SURVEY
UNDER

G 7367 G 6817
 Application No. G. 6867 Permit No. G. 6830.
 IN NAME OF

ESTATE OF JOE D. DOHERTY

Surveyed JULY, 19, 1973, by V. L. CHURCH.....