


T6S. R3W. WM.

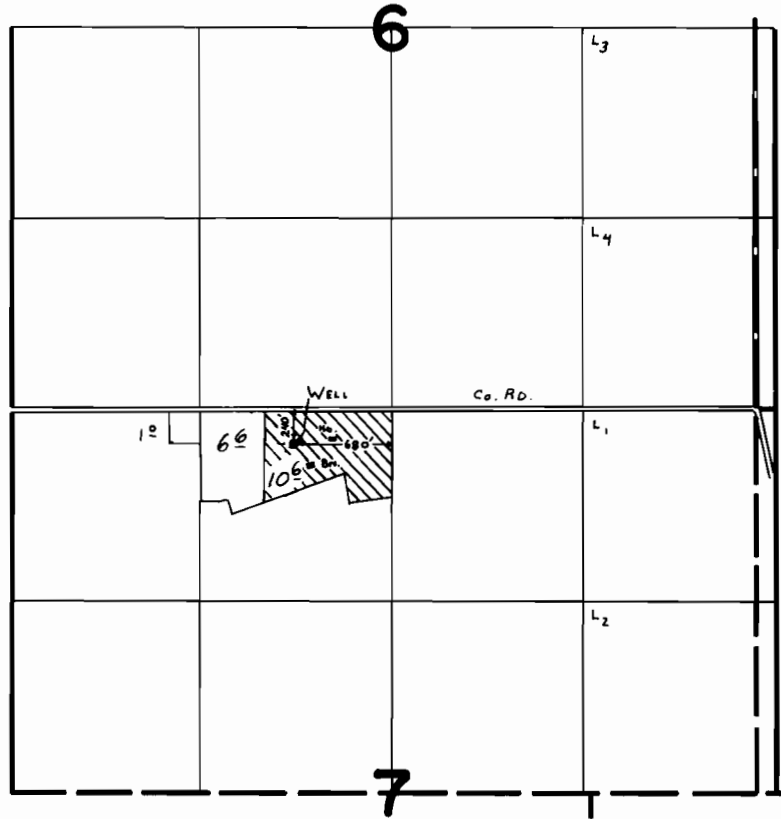

FINAL PROOF SURVEY
UNDER

Application No. G-6912. Permit No. G-6435....
IN NAME OF

LLOYD & LAVINA RAE

Surveyed May 15 1979, by C. L. HUGHES....