


T. 6S. R. 1W. W. M.

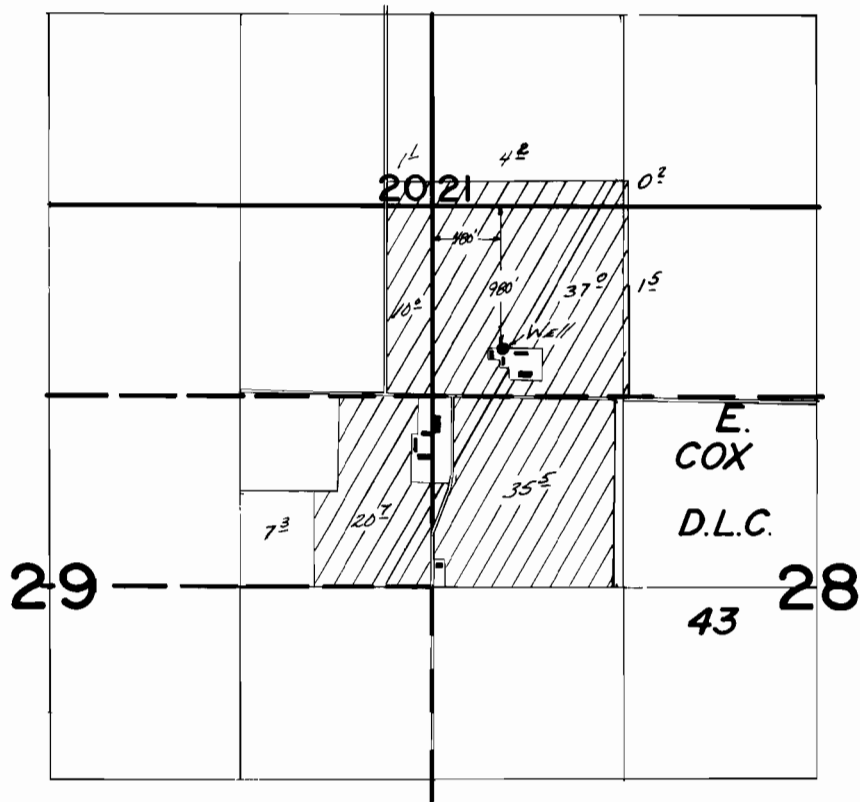

FINAL PROOF SURVEY UNDER

Application No. G-6923 Permit No. G-6442..
IN NAME OF

.....Zitzelberger Brothers.....

Surveyed .Oct...18. 1979., by .C.R.RODRIGUEZ