


T.5S., R.2W., W.M.

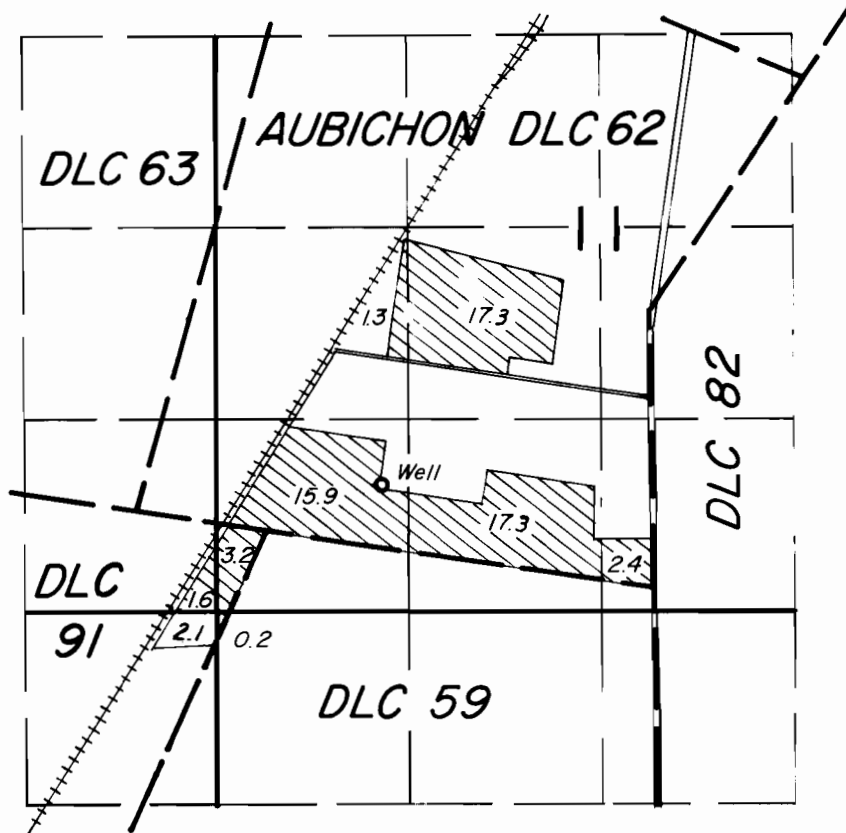

WELL LOC.: 170' N. & 1680' E. From the SW Corner DLC 62

FINAL PROOF SURVEY UNDER

Application No. G-7192 Permit No. G-6623

IN NAME OF

ROY A. PETZEL

Surveyed AUG. 29, 1979, by *AB*