


T.5S., R.3W., W.M.

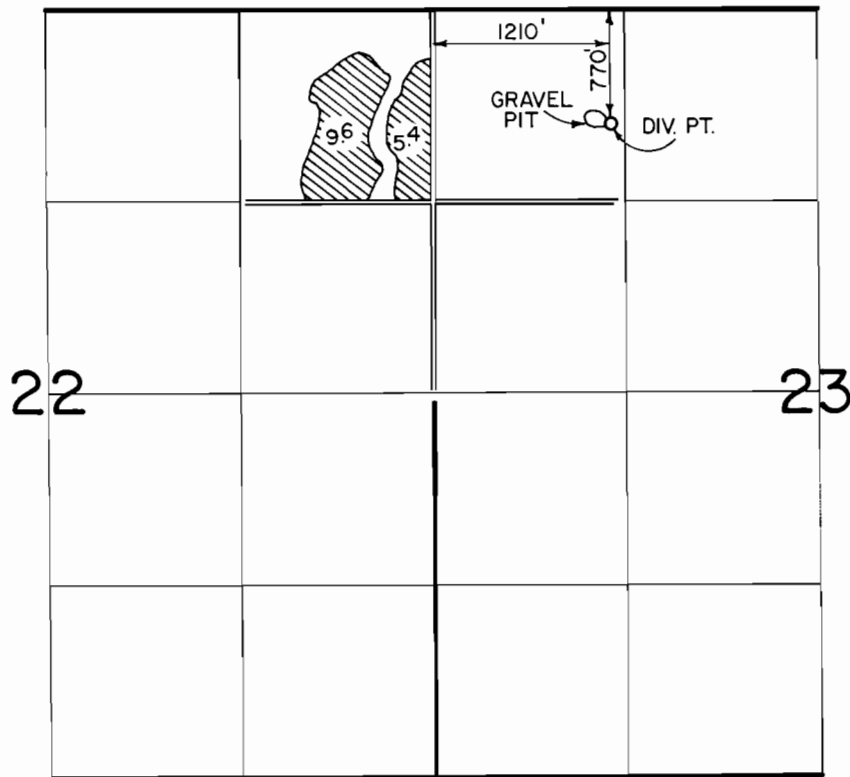

*Unit
f.p. ...
...
... 15/20*

FINAL PROOF SURVEY UNDER

Application No. G-7749 Permit No. G-7178
IN NAME OF

ARNOLD E. HILDEBRANDT

Surveyed MAY 28, 1980, by *Al. Brown*