


# T.7S. R.1W. W.M.

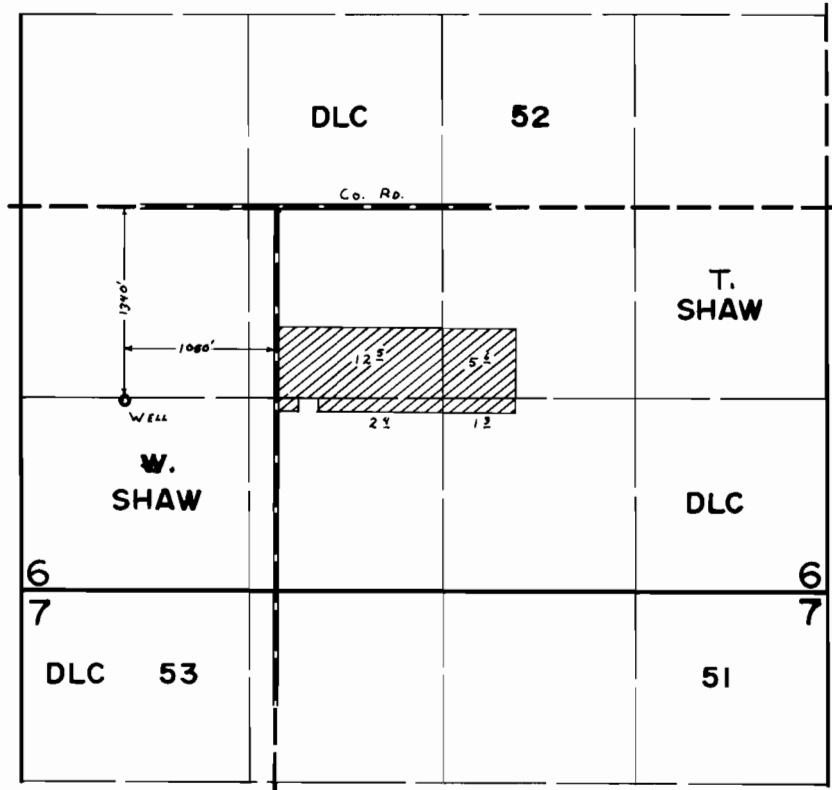

## FINAL PROOF SURVEY UNDER

Application No. ~~G-7764~~ Permit No. ~~G-7204~~  
IN NAME OF

**KING FARMS**

Surveyed ~~JUNE 25~~ 19.80., by ~~C. L. HUGHES~~