


# T.6S. R.2W., W.M.

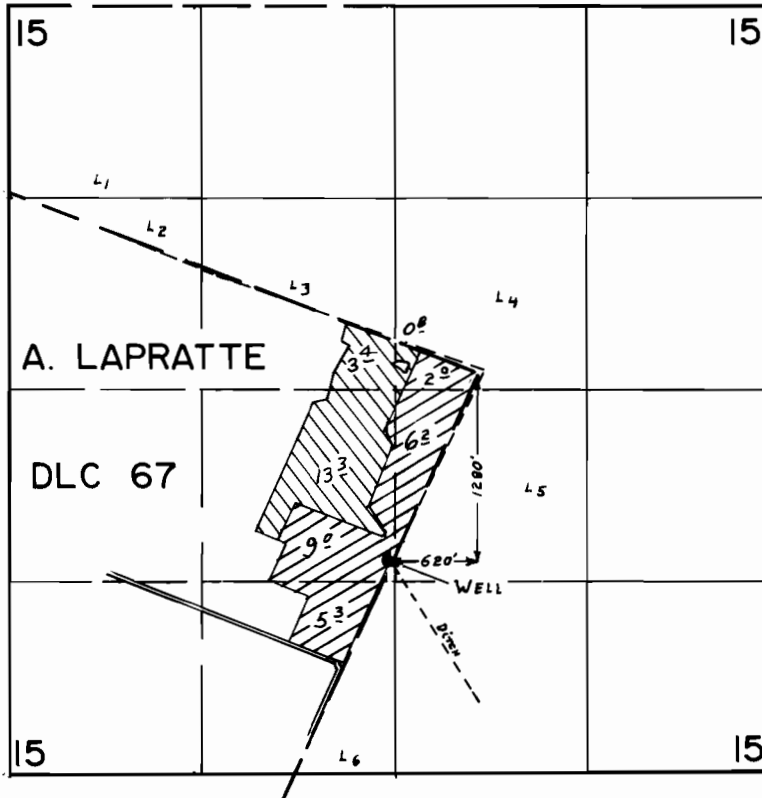

SCALE: 1" = 1320'

## FINAL PROOF SURVEY UNDER

G-11236                      G-10352   
 Application No. G-7814      Permit No. G-7229   
 IN NAME OF

..... JOSEPH HENNY .....

Surveyed APR. 25, 1979, by L. H. NUNN.....  
 (G-11236) AUG. 2 1984      B.W. BISHOP

4/11/85 BWB