


# T.8S. R.4W., W.M.

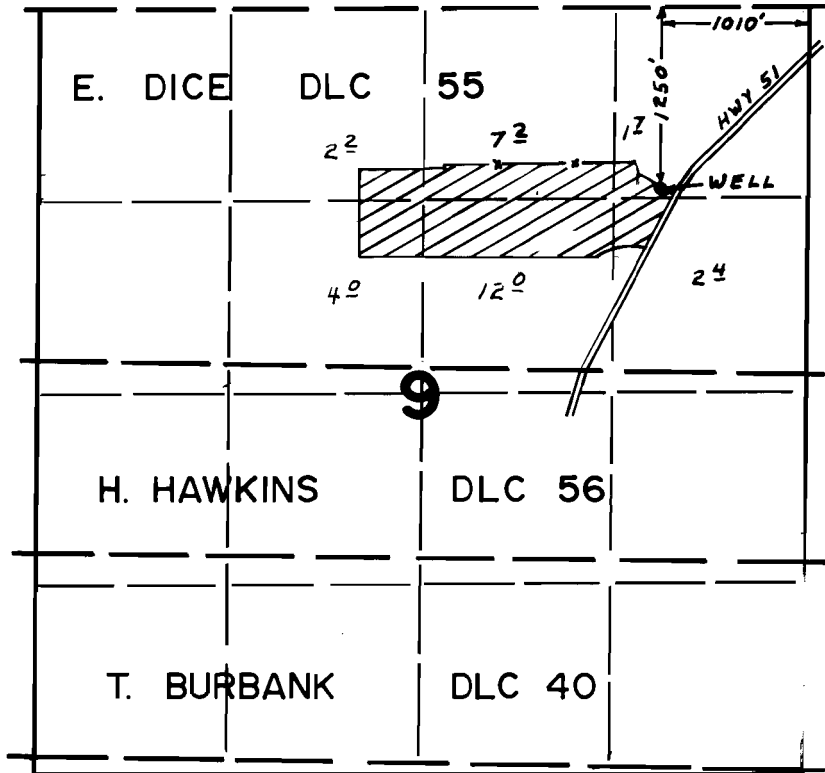

## FINAL PROOF SURVEY UNDER

Application No. G-7847. Permit No. G-7279.  
IN NAME OF

WONDER VIEW FARMS

Surveyed OCT. 13. 1978. by S.P. APPLGATE