


T5S. R1E. WM.

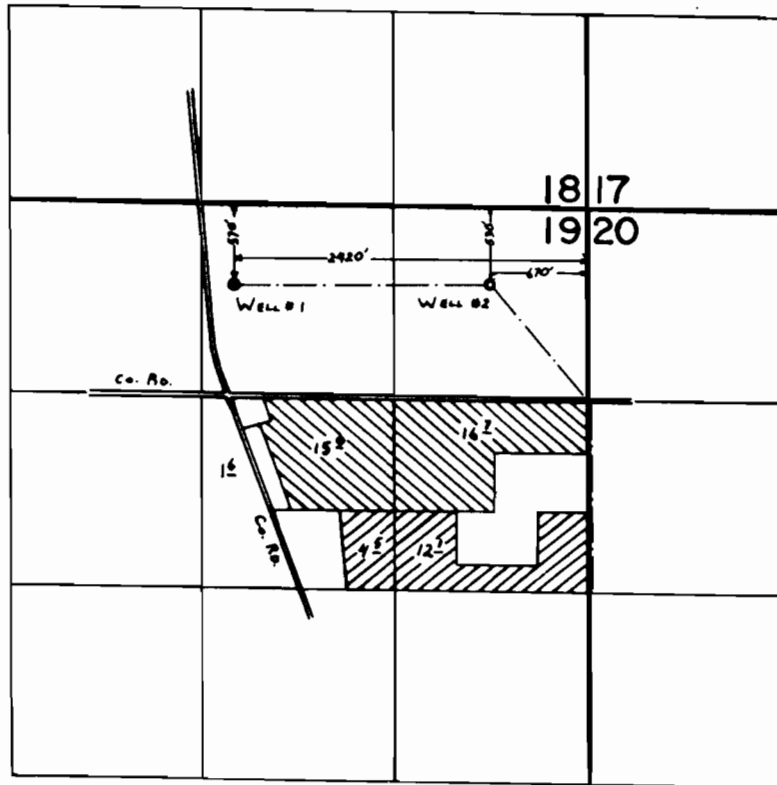

▨ - App. G-7636

▨ - App. G-9146

FINAL PROOF SURVEY UNDER

Application No. G-7636 G-7073
G-9146 Permit No. G-8480
IN NAME OF

HESSEL BIERMA

Surveyed Oct. 12, 1979, by C. L. HUGHES