


# T. 1 S., R. 13 E., W. M.

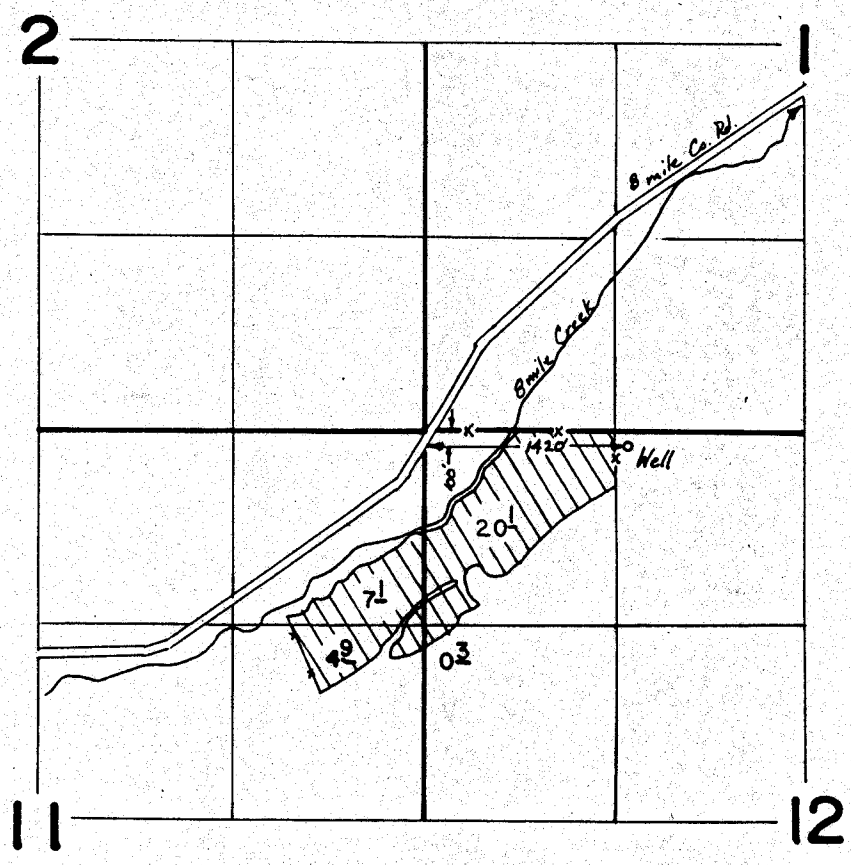

## FINAL PROOF SURVEY UNDER

Application No. G.8186.. Permit No. G.7599...  
IN NAME OF

**TOM MAY**

Surveyed APRIL 27 1978., by S.P. APPELEGATE  
MAY 3, 1983, T. J. PAUL