


B-8075 51903
 8076 51904
 8077 51905
 51905
 T9137

T.26S. R.16E. W.M.

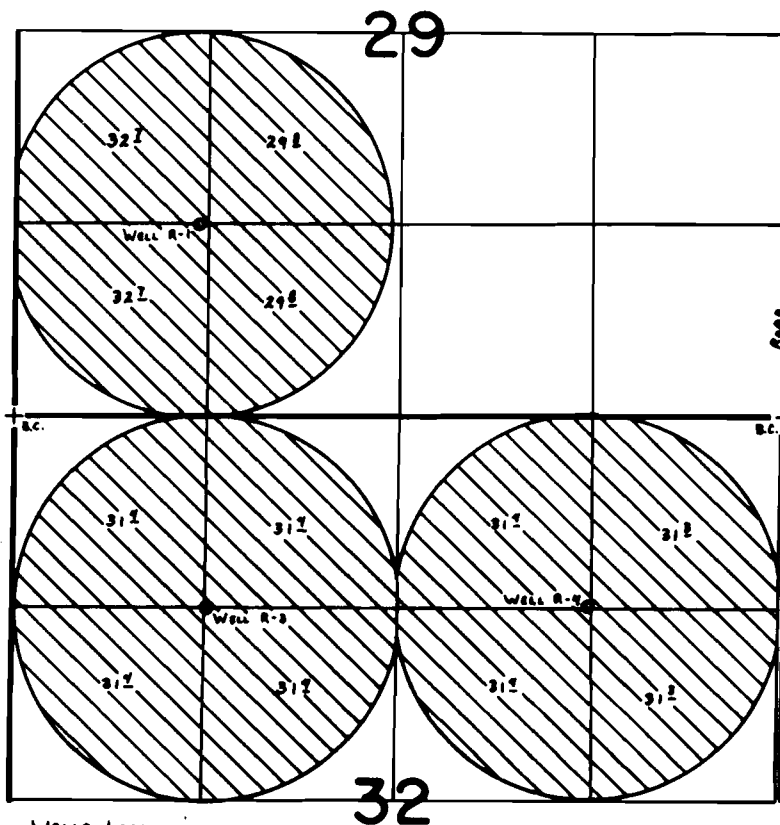

WELLS LOC:

R-1 (App. G-8790) - 1810' N. { 1260' E. } Both From N.W. Cor. SEC. 32.
 R-2 (App. G-8791) - 1930' S. { 1890' E. }
 R-4 (App. G-8792) - 1900' S. { 1930' W. From N.E. Cor. SEC. 32.

FINAL PROOF SURVEY UNDER

G-8790 G-8075
 G-8791 G-8076
 Application No. ~~G-8792~~ Permit No. ~~G-8077~~
 IN NAME OF

CLYDE RITTER

Surveyed Aug. 29, 1978, by S.P. APPLGATE
 Aug. 28, 1979, by C.L. HUGHES