


B-8075 51903
 8076 51904
 8077
 51905
 T9137

T.26S. R.16E. W.M.

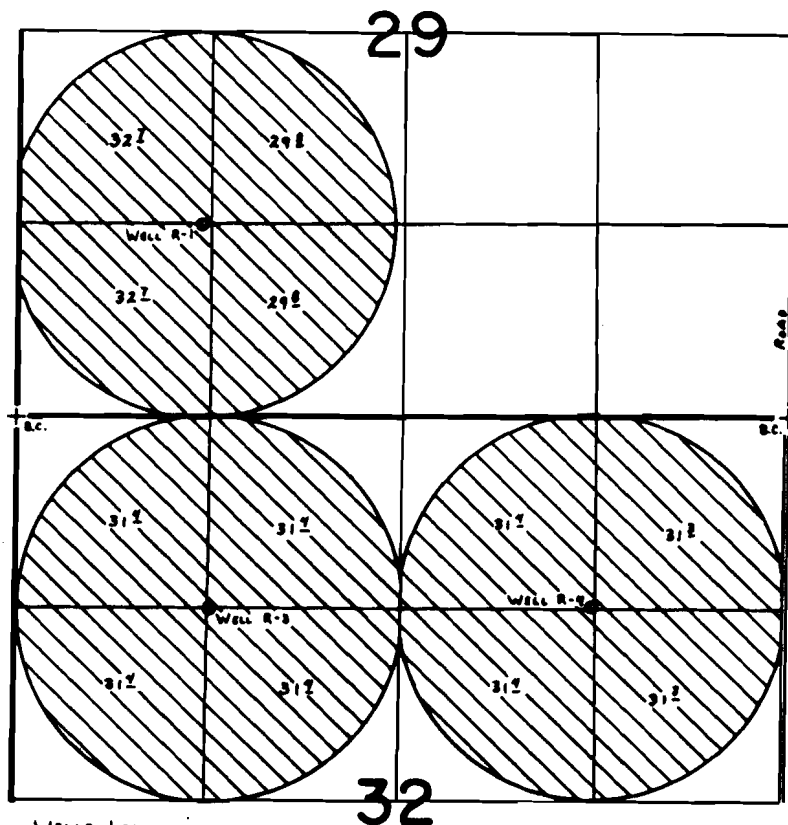

WELLS LOC:

R-1 (APP. G-8790) - 1810' N. { 1260' E. } Both From N.W. Cor. SEC. 32.
 R-2 (APP. G-8791) - 1330' S. { 1840' E. }
 R-4 (APP. G-8792) - 1300' S. { 1230' W. From N.E. Cor. SEC. 32.

**FINAL PROOF SURVEY
 UNDER**

G-8790 G-8075
 G-8791 G-8076
 Application No. ~~G-8792~~ Permit No. ~~G-8077~~...
 IN NAME OF

.....CLYDE RITTER.....

Surveyed Aug. 29, 1978, by S.P. APPELEGATE
 Aug. 28, 1979, by C. L. HUGHES