


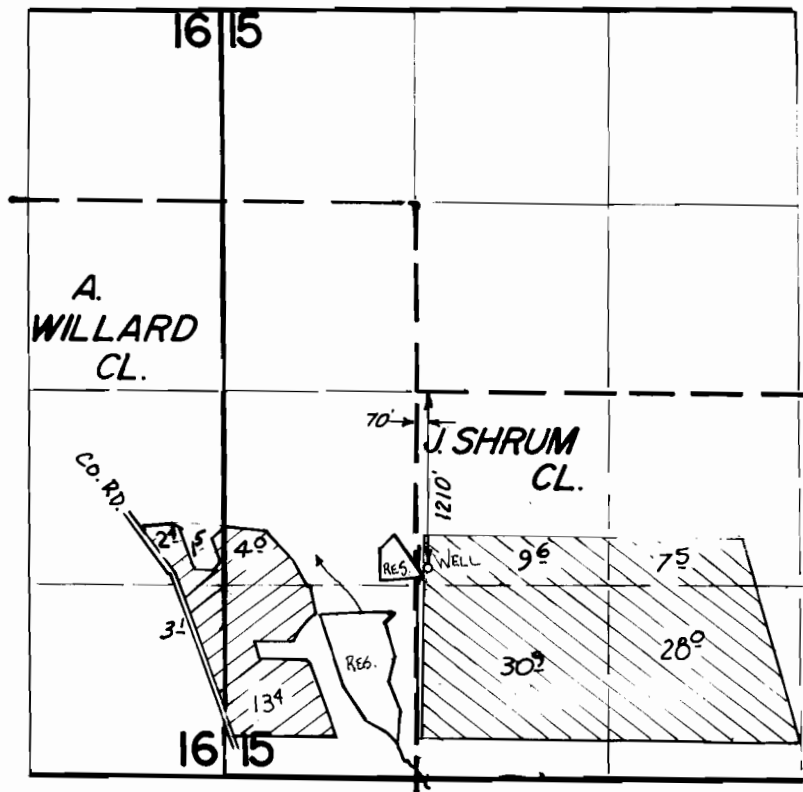

T. 7 S., R. 1 W., WM.



-  Primary
-  Supplemental

FINAL PROOF SURVEY UNDER

Application No. G-9027... Permit No. G-8419.....
IN NAME OF

RICHARD L. BARNES.....

Surveyed MAY 31, 1979, by L. H. NUNN.....