


T. 7 S., R. 1 W., W.M.

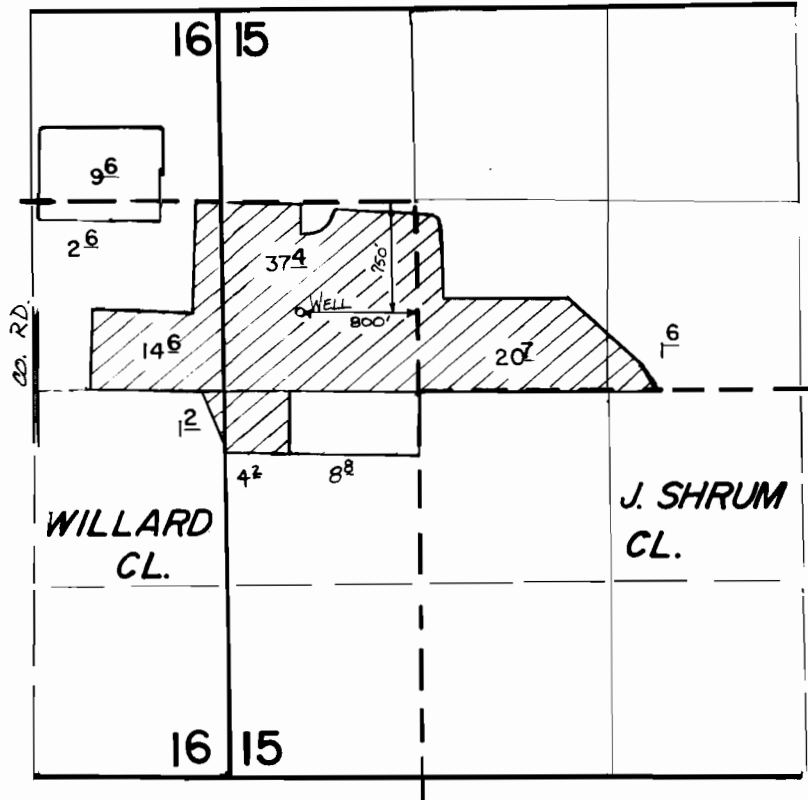

FINAL PROOF SURVEY UNDER

Application No. G. 9608 Permit No. G. 8830
IN NAME OF

ROBERT BARNES

Surveyed NOV. 17, 1983, by M. CAHILL